

WAYNE
 J 113
 7-19-79

MISSISSIPPI
 BOARD OF WATER COMMISSIONERS
 416 North State Street
 Jackson, Mississippi 39201

INDEXED

WATER WELL DRILLERS LOG

7-19-1979 Griner Drilling Wayne
 date well completed firm name county well located

LANDOWNER:
 Mobile Exploration + Production
 S.E. Corporation
 100 Howard Avenue Plaza
 Towers Bldg.
 New Orleans (mailing address) La.

description of formations encountered	from	to
Chalk + rock	0	273
Shell + sand	273	347
Chalk	347	430
lime rock	430	465
Chalk	465	504

WELL LOCATION: 500'S + 1500'W of
 sec. 11 T. 9 N. R. 6 E NE/4
 S W

Waynesboro
 (distance) miles (direction) of (nearest town)

WELL PURPOSE: oil field supply
 (home, irrigation, municipal, industrial)

WELL COMPLETION DATA:

- (1) diameter (inches) 3"
- (2) total depth (feet) 504'
- (3) static water level (feet) 100' ^{below} top of ground
- (4) casing steel 399' (material) (depth)
 3" (size) if telescope see back.
- (5) screen 42' 357' (length) (depth to top)
 3" perforated (size) (material)
- (6) pump — 70 (HP) (yield gpm)
 AC (type power)
- (7) electric log — (yes or no)

(organization running log)

(8) how well bottom plugged orange
 peel

Miss. Board of Water Comm.


AUG 20 1979

DRILLERS REMARKS:

RECEIVED

If well telescopes please sketch and show depths.

GROUND LEVEL

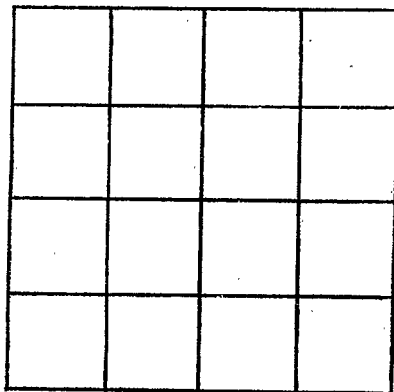

SECTION _____

Please indicate well location X.

ADDITIONAL INFORMATION

If more than one screen, show locations of each on sketch.