

MISSISSIPPI DEPARTMENT OF NATURAL RESOURCES

Bureau of Land and Water Resources

Southport Mall

P.O. Box 10631

Jackson, Mississippi 39209

WATER WELL DRILLERS LOG

CODED

WAYNE  
J 114  
12-19-80

Gunter Drilling Service, Inc. Wayne

date well completed

firm name

county well located

LANDOWNER:

Natomus of North America  
Suite 700 5251 Westman  
Houston, Texas  
(mailing address)

description of formations encountered

from

to

Clay rock sand 0 644

WELL LOCATION:

1840'S + 1718' E

sec 30 T 9 N R 6 E of  
Audrey Sapin Waynesboro  
(distance) (direction) (nearest town)

WELL PURPOSE:

(home, irrigation, municipal, industrial)

WELL COMPLETION DATA:

- (1) diameter (inches) 3"
- (2) total depth (feet) 644'
- (3) static water level (feet) 180' below top of ground
- (4) casing steel, 400' (material), (depth)  
4" (size) if telescope see back.
- (5) screen open ended (length), (depth to top)  
(size), (material)
- (6) pump 70 (HP), (yield gpm)  
ac (type power)
- (7) electric log (yes or no)  
(organization running log)
- (8) how well bottom plugged range  
peel

DEPT. OF NATURAL RESOURCES  
BUREAU OF LAND & WATER RESOURCES


JAN 19 1981

RECEIVED

DRILLERS REMARKS:

If well telescopes please  
sketch and show depths.

GROUND LEVEL

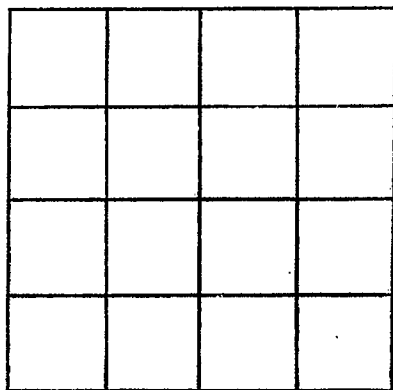

SECTION \_\_\_\_\_

Please indicate well location X.

ADDITIONAL INFORMATION

If more than one screen,  
show locations of each on sketch.