

MISSISSIPPI DEPARTMENT OF NATURAL RESOURCES

Bureau of Land and Water Resources

Southport Mall

P.O. Box 10631

Jackson, Mississippi 39209

WATER WELL DRILLERS LOG

7
CODED

Wayne
J-115
1-21-81

Griner Drilling Service, Inc.

Wayne

date well completed

firm name

county well located

LANDOWNER:

Natomus of North America
Suite 700 5251 Westmore
Houston, Texas
(mailing address)

description of formations encountered

from

to

clay, rock

0 224

clay

224 651

WELL LOCATION: 1840 S + 1718' E

No. 1
Audrey 30 T 9 S R 6 E of
Saxon Wayneboro
(distance) (direction) (nearest town)

WELL PURPOSE: oil field supply
(home, irrigation, municipal, industrial)

WELL COMPLETION DATA:

2nd Water Well drilled and location
(1) diameter (inches)
(2) total depth (feet)
(3) static water level (feet) below above top of ground.
(4) casing (material) (depth) (size) If telescope see back.

(5) screen (length) (depth to top)

(size) (material)

(6) pump (HP) (yield gpm)

(type power)

(7) electric log (yes or no)

(organization running log)

(8) how well bottom plugged

DRILLERS REMARKS:


DEPT. OF NATURAL RESOURCES
BUREAU OF LAND & WATER RESOURCES

JAN 26 1981

RECEIVED

If well telescopes please
sketch and show depths.

GROUND LEVEL

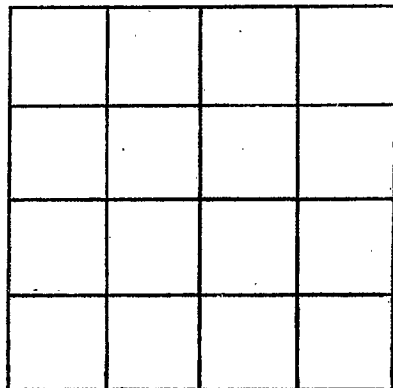

SECTION _____

Please indicate well location X.

ADDITIONAL INFORMATION

If more than one screen,
show locations of each on sketch.