

**WAYNE**  
**J 117**  
**2-13-76**

MISSISSIPPI  
 BOARD OF WATER COMMISSIONERS  
 416 North State Street  
 Jackson, Mississippi 39201

WATER WELL DRILLERS LOG  
 McILWAIN WATER WELL SERVICE

**FEB 13, 1976** 19 **RT 2, BOX 37** **WAYNE**  
 date well completed **WAYNESBORO, MISS, 39071** county/well located


LANDOWNER:	description of formations encountered	from	to
<b>EDDIE BLACKLEDGE</b> <b>Route 2 WAYNESBORO, Miss.</b> (mailing address)			
<b>WELL LOCATION:</b> sec. <b>22</b> T <b>9</b> N R. <b>6</b> <b>6</b> miles <b>NE</b> of <b>W'BORO</b> (distance) (direction) (nearest town)	<b>Red Sand</b>	<b>12</b>	<b>25</b>
<b>WELL PURPOSE:</b> <b>HOME</b> (home, irrigation, municipal, industrial)	<b>White Sand</b>	<b>25</b>	<b>39</b>
<b>WELL COMPLETION DATA:</b>	<b>Clay</b>	<b>39</b>	<b>43</b>
(1) diameter (inches) <b>2"</b>	<b>Sand + Clay</b>	<b>43</b>	<b>50</b>
(2) total depth (feet) <b>62'</b>	<b>Sand</b>	<b>50</b>	<b>62</b>
(3) static water level (feet) <b>52</b> <small>below above</small> top of ground.			
(4) casing <b>PVC</b> <b>58'</b> (material) (depth) <b>2"</b> If telescope see back. (size)			
(5) screen <b>4'</b> <b>58'</b> (length) (depth to top) <b>2"</b> <b>PVC</b> (size) (material)			
(6) pump <b>1</b> <b>9</b> (HP) (yield gpm) <b>110 AC</b> (type power)			
(7) electric log <b>no</b> (yes or no)  (organization running log)			
(8) how well bottom plugged			
<b>DRILLERS REMARKS:</b>			

RECEIVED  
 MAR 11 1976

MISS. Bd. OF WATER COMM.

If well telescopes please sketch and show depths.

GROUND LEVEL

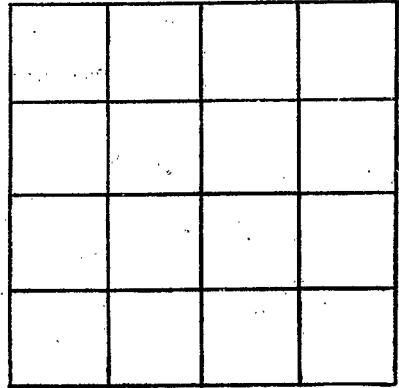

SECTION \_\_\_\_\_

Please indicate well location X.

ADDITIONAL INFORMATION

If more than one screen, show locations of each on sketch.