

MISSISSIPPI DEPARTMENT OF NATURAL RESOURCES

Bureau of Land and Water Resources

Southport Mall

P.O. Box 10631

CODED

Jackson, Mississippi 39209

WATER WELL DRILLERS LOG

J118
Wayne
12-24-84

Griner Drilling Service, Inc.

Wayne

12-24-84
date well completed

Griner Drilling Service, Inc.
firm name

Wayne
county well located

LANDOWNER:
Murco Drilling Corp.
1908 Beck Bldg.
Shreveport, La. 71101
(mailing address)

description of formations encountered

from to

clay, rock, with breaks of sand 0 577'

WELL LOCATION: 1820' N + 280' E
sec 32 T 9 N R 6 E SW 100
No. 1 Edna Waynesboro
E. Gray miles of
(distance) (direction) (nearest town)

CODED

WELL PURPOSE: oilfield supply
(home, irrigation, municipal, industrial)

WELL COMPLETION DATA:


- (1) diameter (inches) 4"
- (2) total depth (feet) 577'
- (3) static water level (feet) 90' (below above top of ground)
- (4) casing Steel 399' (material) (depth)
4" (size) if telescope see back.
- (5) screen open, ended (length) (depth to top)
(size) (material)
- (6) pump 75 (HP) (yield gpm)
AC (type power)
- (7) electric log (yes or no)
(organization running log)
- (8) how well bottom plugged Orange
peel

Revised 12/24/84

DRILLERS REMARKS:

If well telescopes please sketch and show depths.

GROUND LEVEL

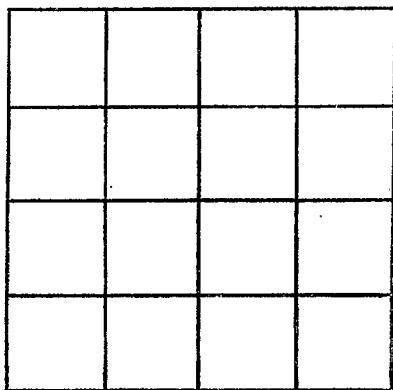

SECTION _____

Please indicate well location X.

ADDITIONAL INFORMATION

If more than one screen,
show locations of each on sketch.