

MISSISSIPPI DEPARTMENT OF NATURAL RESOURCES

Bureau of Land and Water Resources

Southport Mall

P.O. Box 10631

Jackson, Mississippi 39209

WATER WELL DRILLERS LOG

CODED

WAYNE
J119

2-17-86 Griner Drilling Service, INC. Wayne
 date well completed firm name county well located

LANDOWNER:	description of formations encountered	from	to
Chesley Pruet Drilling P.O. Box 324 Laurel, Ms. 39440 (mailing address)	sand, chalk	0	42
WELL LOCATION: 900' N & 950' E sec. 7 T 90 N R 6 E of survey Cenergy Exploration Diamond No. 5 Gray (direction of nearest town)	chalk, rock	42	252
WELL PURPOSE: oilfield rig (home, irrigation, municipal, industrial)	chalk	252	270
WELL COMPLETION DATA:	sand, rock	270	316
(1) diameter (inches) 3"	chalk	316	319
(2) total depth (feet) 319'			
(3) static water level (feet) 150' (below top of ground)			
(4) casing steel 315' (material), (depth) 3" (size) if telescope see back.			
(5) screen 42' (length), 273' (depth to top) 3" perforated (size), (material)			
(6) pump — (HP), 45 (yield gpm) AC (type power)			
(7) electric log (yes or no) (organization running log)			
(8) how well bottom plugged orange peel			
DRILLERS REMARKS:			


CODED

RECEIVED

Department of Natural Resources
 Bureau of Land and Water Resources

If well telescopes please sketch and show depths.

GROUND LEVEL

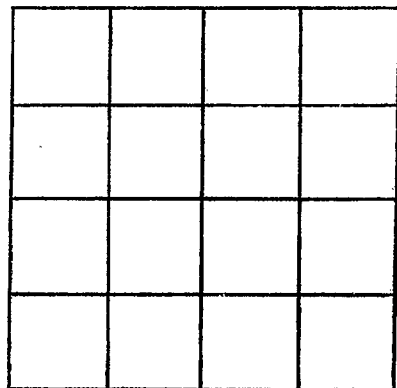

SECTION _____

Please indicate well location X.

ADDITIONAL INFORMATION

If more than one screen, show locations of each on sketch.