

MISSISSIPPI DEPARTMENT OF NATURAL RESOURCES

Bureau of Land and Water Resources

Southport Mall

P.O. Box 10631

Jackson, Mississippi 39209

WATER WELL DRILLERS LOG

Griner Drilling Service, Inc.

Wayne

WAYNE
J 121

1-24-87
date well completed

firm name

county well located


LANDOWNER:	description of formations encountered	from	to
Tesoro Petroleum Corp. P.O. Box 2909 Laurel, MS. 39442 (mailing address)	SAND, CLAY	0	120
WELL LOCATION: 2100'S & 2400'W sec. 32 T. 9 N. R. 6 E of CONQUEST WAYNESBORO FIELD Exploration (distance) miles (direction) of (nearest town) No. 1 Southeastern Oil Co. #1	CLAY, ROCK, SAND	120	546
WELL PURPOSE: oil field rig (home, irrigation, municipal, industrial) supply	SAND, few small breaks of clay	546	630
WELL COMPLETION DATA:			
(1) diameter (inches) 3"			
(2) total depth (feet) 630'			
(3) static water level (feet) 150' below top of ground.			
(4) casing steel 630' (material) (depth) 3" (size) if telescope see back.			
(5) screen 63' 567' (length) (depth to top) 3" perforated (size) (material)			
(6) pump AC (HP) 90 (yield gpm) (type power)			
(7) electric log (yes or no)			
(organization running log)			
(8) how well bottom plugged ORANGE peel			
DRILLERS REMARKS:			

RECEIVED
JAN 30 1987

Department of Natural Resources
Bureau of Land & Water Resources

If well telescopes please sketch and show depths.

GROUND LEVEL

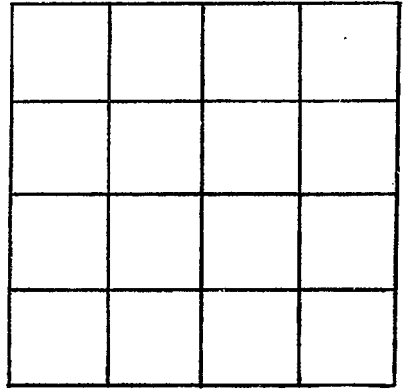

SECTION _____

Please indicate well location X.

ADDITIONAL INFORMATION

If more than one screen,
show locations of each on sketch.