

MISSISSIPPI DEPARTMENT OF NATURAL RESOURCES

Bureau of Land and Water Resources

Southport Mall

P.O. Box 10631

Jackson, Mississippi 39209

WATER WELL DRILLERS LOG

WAYNE
<del>XX</del>
J122

Griner Drilling Service, Inc.

CODED  
Wayne

7-15-87  
date well completed

firm name

county well located

LANDOWNER:  
Chesley Drilling Service  
P.O. Box 324  
Laurel, Ms. 39440  
(mailing address)

description of formations encountered	from	to
SAND	0	60
clay, rock, SAND	60	620

WELL LOCATION: 820'S + 150'W  
sec. 18 T 9 N R 6 E of  
No. 1 Nolan Diamond Field  
1/4 mile (distance) (direction) (nearest town)

WELL PURPOSE: oilfield supply  
(home, irrigation, municipal, industrial)

- WELL COMPLETION DATA:
- (1) diameter (inches) 3"
  - (2) total depth (feet) 620'
  - (3) static water level (feet) 190' below top of ground
  - (4) casing Steel 504' (material) (depth)  
3" (size) If telescope see back.
  - (5) screen Open ended (length) (depth to top)  
3" (size) (material)
  - (6) pump 45 (HP) (yield gpm)  
AC (type power)
  - (7) electric log (yes or no)

CODED

RECEIVED

SEP 21 1987


Department of Natural Resources  
Bureau of Land and Water Resources

(8) how well bottom plugged  
orange  
peel

DRILLERS REMARKS:

If well telescopes please sketch and show depths.

GROUND LEVEL

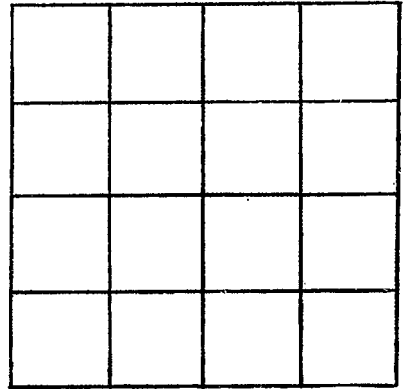

SECTION \_\_\_\_\_

Please indicate well location X.

ADDITIONAL INFORMATION

If more than one screen, show locations of each on sketch.