

MISSISSIPPI DEPARTMENT OF NATURAL RESOURCES

Bureau of Land and Water Resources

Southport Mall

P.O. Box 10631

Jackson, Mississippi 39209

WATER WELL DRILLERS LOG

Griner Drilling Service, INC.

Wayne

Wayne
J 123

Coded

2-13-88

date well completed

firm name

county well located

LANDOWNER:

Chesley Pruet Drilling Co.

P.O. Box 324

Laurel, Ms. 39440

(mailing address)

description of formations encountered

from

to

SAND
clay, rock, sand *0 35*
35 609

WELL LOCATION: *500' x 2100' E/W*

sec. *18* T. *9* S. R. *6* E. OF

NO. 18-2 Mathersville
well

(distance) (direction) (nearest town)

WELL PURPOSE: *oilfield, rig supply*

(home, irrigation, municipal, industrial)

WELL COMPLETION DATA:

(1) diameter (inches) *3"*

(2) total depth (feet) *609'*

(3) static water level (feet) *130'* *below* top of ground.

(4) casing *steel, 420'*

(material) (depth)

3" If telescope see back.

(size)

(5) screen *Open ended*

(length) (depth to top)

(size) (material)

(6) pump *75*

(HP) (yield gpm)

AC

(type power)

(7) electric log _____

(yes or no)

(organization running log)

(8) how well bottom plugged *open ended*

DRILLERS REMARKS:


RECEIVED

MAR 11 1988

Department of Natural Resources
Bureau of Land & Water Resources

If well telescopes please sketch and show depths.

GROUND LEVEL

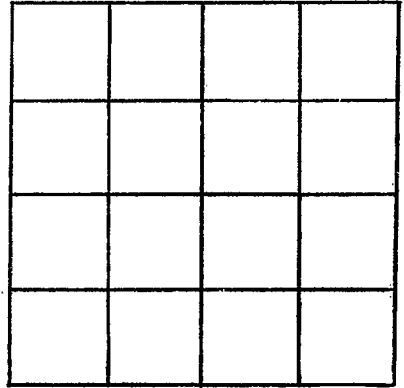

SECTION _____

Please indicate well location X.

ADDITIONAL INFORMATION

If more than one screen, show locations of each on sketch.