

MISSISSIPPI DEPARTMENT OF NATURAL RESOURCES
Bureau of Land and Water Resources

Southport Mall
P.O. Box 10631

Jackson, Mississippi 39209

WATER WELL DRILLERS LOG

Griner Drilling
Service, Inc.

Wayne

Department of Natural Resources

Bureau of Land and Water Resources

date well completed

firm name

county well located

LANDOWNER:

OXY, U.S.A., Inc.
P.O. Box 12026
JACKSON, MS. 39326
(mailing address)

description of formations
encountered

from

to

clay, rock, sand 0 650

WELL LOCATION: 930'N + 989'W

sec. 36 T. 9 N. R. 6 E. of
SE/40

E. Waynesboro Field
(direction) (nearest town)

WELL PURPOSE: oilfield rig
(home, irrigation, municipal, industrial)
supply

WELL COMPLETION DATA:

(1) diameter (inches) 3"
(2) total depth (feet) 650'
(3) static water level (feet) 115' below
top of ground.

(4) casing PVC 440'
(material) (depth)

3" if telescope see back.
(size)

(5) screen Open ended
(length) (depth to top)

(size) (material)

(6) pump Airlift Water Well
(HP) (yield gpm)

A.C.
(type power)

(7) electric log (yes or no)


(organization running log)

(8) how well bottom plugged Plug 3"

DRILLERS REMARKS:

If well telescopes please
sketch and show depths.

GROUND LEVEL

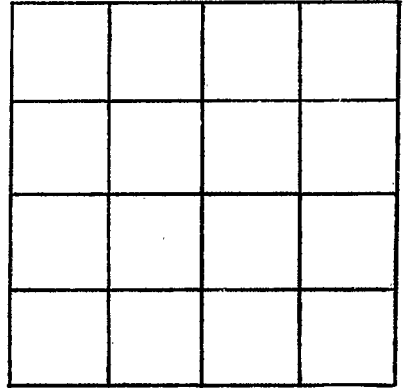

SECTION _____

Please indicate well location X.

ADDITIONAL INFORMATION

If more than one screen,
show locations of each on sketch.