

MISSISSIPPI DEPARTMENT OF NATURAL RESOURCES

Bureau of Land and Water Resources

Southport Mall

P.O. Box 10631

Jackson, Mississippi 39209

WATER WELL DRILLERS LOG

Griner Drilling Service, INC.

Wayne

6-7-90 date well completed

firm name

county well located

LANDOWNER:

OXY, U.S.A., INC.
P.O. Box 12026
Jackson, Ms. 39326
(mailing address)

description of formations encountered

description of formations encountered	from	to
WAYNE J126 clay & sand	0	21
clay, rock	21	450
sand	450	485
sand	485	510

WELL LOCATION:

240'W x 120'W
Sec 36 T 9(N) R 6 E of
E. Waynesboro Field
(place) (direction) (nearest town)

WELL PURPOSE:

oilfield rig supply
(home, irrigation, municipal, industrial)

WELL COMPLETION DATA:

- (1) diameter (inches) 4"
- (2) total depth (feet) 510'
- (3) static water level (feet) 85' below top of ground.
- (4) casing PVC 485' (material) (depth)
4" (size) if telescopic see back.
- (5) screen 30' 485' to 510' top (length) (510' top)
4" PVC screen (size) (material)
- (6) pump 7 1/2 100 (HP) (yield gpm)
230 Volt 3 phase (type power)
- (7) electric log (yes or no)

(organization running log)

- (8) how well bottom altered 4" backwash valve

DRILLERS REMARKS:

RECEIVED
JUL 09 1990

Department of Natural Resources
Bureau of Land & Water Resources


Cold

11/90

NO. 2
Hemming
11A

If well telescopes please sketch and show depths.

GROUND LEVEL

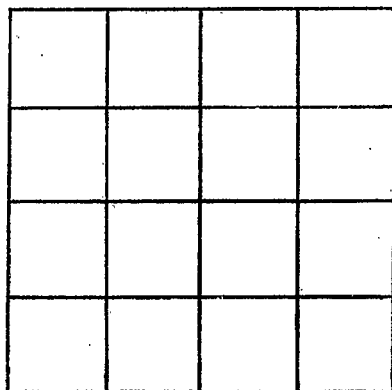

SECTION _____

Please indicate well location X.

ADDITIONAL INFORMATION

If more than one screen,
show locations of each on sketch.