

MISSISSIPPI DEPARTMENT OF NATURAL RESOURCES

Bureau of Land and Water Resources

Southport Mall

P.O. Box 10631

Jackson, Mississippi 39209

WATER WELL DRILLERS LOG

Griner Drilling Service, Inc.

Wayne

Wayne
 ST 127

11-4-90 date well completed

Griner Drilling Service, Inc. firm name

Wayne county well located

LANDOWNER:	description of formations encountered	from	to
OXY, U.S.A., Inc. Jackson, Ms. (mailing address)	clay, rock, sand, shale	0	567
WELL LOCATION: 1410' N & 1650' W No. 3 Hemming "A" W. Waynesboro Field 36 T 9 N R 6 E of (distance) (direction) (nearest town)			
WELL PURPOSE: oilfield no supply (home, irrigation, municipal, industrial)			
WELL COMPLETION DATA:			
(1) diameter (inches) 4"			
(2) total depth (feet) 567'			
(3) static water level (feet) 150' below top of ground.			
(4) casing PVC 380' (material) (depth) 4" (size) If telescope see back.			
(5) screen No screen (length) (depth to top) open ended well (size) (material)			
(6) pump Airlift 75 (HP) (yield gpm) Air Compressor (type power)			
(7) electric log (yes or no)			
(organization running log)			
(8) how well bottom plugged 4" PVC plug			
DRILLERS REMARKS:			


RECEIVED

JAN 16 1991

Dept. of Environmental Quality
 Bureau of Land & Water Resources

If well telescopes please sketch and show depths.

GROUND LEVEL

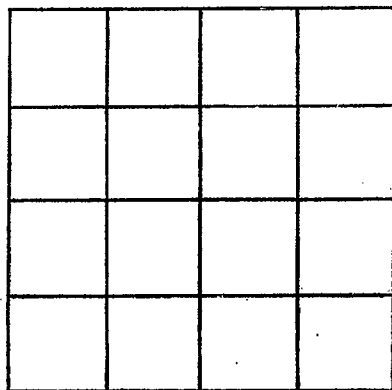

SECTION _____

Please indicate well location X.

ADDITIONAL INFORMATION

If more than one screen,
show locations of each on sketch.