	State Well Report	For Office Use Only:	
County: WAYNE	Part 1 – Driller's Log		
	Mississippi Department of Environmental Qu	ality Aquifer:	
Permit #:	Office of Land and Water Resources P.O. Box 2309	Well #: 5152	
Driller: EARI MOSTLey	Jackson, MS 39225		
Date drilling completed: $1 - 30 - 15$	(601)961- 5210	L. S. Elevation:	
	(601)961- 5228 (fax)	E-log #:	
State Law requires that this repo	rt be prepared by the license holder responsib	le for the work and filed with the	
Department at the above adaress Information on Well	s within 30 days of completion of drilling of the	l or Borehole Location	
(Landowner if borehole is not f	for a water wall		
Ourse LADAY CA	Latitude 3/ ° 44	Latitude: 31 . 44 . 322 Longitude: 88 36. 50	
Owner Name <u>LARRY</u> GAN Mailing Address: <u>78</u> <u>B4FF02</u>	Method of Lat/Long (c	circle one): Conventional Survey,	
Mailing Address: 10 84Ff.02	OGANOY BO	nd-held GPS, Survey-grade GPS	
	Return 1/1 NE 1/4 Sec	nd-held GPS, Survey-grade GPS : <del>20</del> Twn <u>9M</u> Rng <u>6</u> U	
City Sta	ns 57367		
	S Miles Eg	ction Nearest Town 55 of <u>unynesson</u>	
Telephone No. (61) 410 48	63	/	
·····	Well / Borehole Data		
Date drilling started: 1-29-15 Date d	rilling completed: 1-30-15 Hole depth: 7	Hole diameter: 4"	
Logs run (circle all applicable): No log run Name of organization running log(s):		tron Other:	
Purpose of borehole (check one): Water V	Vell Geotechnical/Geological Investigation	Ground Source Heat Pump	
Seismic	SurveyOther ( <i>describe</i> ) d to water well construction, skip the remainder of	this black	
· · · · · ·	Industrial Public Supply Irrigation Fish C		
_	on: Valve Other (describe)		
Static Water Level:feet a	bove or below (circle one) land surface Date mea	asured: 1 - 30 - 15	
	iteel tape electric tape air line other		
	epth of <u>h</u> feet Type of grout (circle one). No		
	ng diameter: <u>4</u> inches Type of ca		
	een diameter: <u>4</u> inches Type of scr		
Screen slot size: $\#8$ inches	Setting depth: From <u>50</u> feet to		
	Gravel packed Underreamed Telescoped	Open hole Natural Development	
Type of completion (circle all applicable)			
Type of completion (circle all applicable)	Other (describe):		
	Other (describe):		


£

4 ک

MAR 02 2015

BY: OLWR

## The sketch below only required for water wells

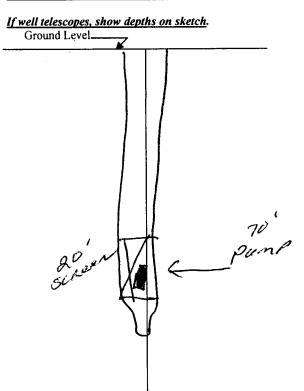

Description of formations encountered must be provided for all	
wells and boreholes, unless specifically exempted by regulations	

Description of Formations Encountered	From (depth)	To (depth)
TOP SOFL Red SAND Fine SHARPESAND	Ground Level	
Bed SAND		25
Fine SHARPESPRO	25	45
COURSE, SAND	45	58
CLAY	58	60
CIAY Med SAND CIAY	60	70
CIAN	70	12

If more than one screen, show location of each on sketch

Sketch the property layout and include the following: 1) the well location; 2) any permanent structures on the property that may aid in locating the well; 3) any roads, power lines, or other items that may aid in locating the property and the well; 4) a north arrow.

84 EAST TO OID 84 ON LEFT GU'LY MILE TO BUFFORD GANDY ON LEFT GU ADOUT 11/2 TO BRICK HOUSE ON RIGHT Landowner Name: \_\_\_\_

Form: OLWR-SWR-1A (04/08)

I certify that the well/borehole was drilled, constructed, and completed in accordance with all applicable requirements of the Mississippi Department of Environmental Quality and the Mississippi Department of Health regulations, if applicable, and state

laws. Earl Moseley 5496

Earl Mosely

Print Name of Responsible Licensee and License No.

Date

Signature of Licensee

	STATE WI	ELL REPORT		
County: <u>UAYNE</u> Permit #: Driller: <u>EAL</u> <u>Moseley</u> Date completed: <u>2-30-15</u> <u>Copy information from block on Part 1</u> This part of the report must be completed report must be attached and both parts fill Well Owner Informa Owner Name: <u>LALAY</u> <u>GAMA</u> Mailing Address: <u>78 Buff</u>	P Pump Installer' Mississispi Departmer Office of Land P.O. Jackson (601) (601)96 by a licensed water well ded with the Department of tion	art 2 s Completion Report and Water Resources Box 2309 a, MS 39225 1961-5210 1-5228 (fax) contractor or a licensed pump in at the above address within 30 da Wel Latitude: <u>31-44</u> .222	For Office Use Only: Aquifer: Well #: 5152 Elevation: I Location Longitude: 033-36-582 he): Conventional Survey_,	
<u>Gamoy RD</u> <u>WAyoresSono</u> City State Telephone No. ( <u>G1</u> ) 410 - 48	<u>735 39367</u> Zip Code	USGS quad, Hand-held GPS Survey-grade GPS_ SW 4 NE 4 Sec 20 T 9 N R 6000 Distance Direction Nearest Town <u>3</u> Miles EAST of waynes come		
Pump Type Circle one		Power Type Circle one		
Air Lift Jet	Submersible	Diesel Engine Gasoli	ne Engine Natural Gas	
Bucket Piston	Turbine	Electric Motor Hand	Tractor PTO	
Centrifugal Rotary	Flowing Well	Windmill Other	(specify):	
Other (specify):		Horse Power Rating of Motor	140	
Date Pump Installed: <u>1-31-15</u>		Setting Depth: 70 '	feet	
Rated Pump Capacity:		Number of Stages:9		
Pump Test Data		Method of Measuring Water Level Circle one		
Date Well Tested: $1-31-15$ Static Water Level (A): $44^{\circ}$ Fee Pumping Water Level (B): $70^{\circ}$ Feet Drawdown [(B) – (A)]: $24^{\circ}$ Fee	Below Land Surface	Air Line Electric Mea Other (specify):		
Test Pumping Rate: 2 4 Duration of Pump Test (minimum 4 hours)		Well yieldedfeet after	hours of pumping	
I HEREBY CERTIFY that the above states <u>Earl Moseley</u> Print Name of Pump Installer and License	5496	of my knowledge. <u>Earl Ma</u> Signature of Pump In	Form: OLWR-SWR-1B (04/0	

1 **4** 

Ł

BY: OLWR