

Wayne
 J 3000
 11-3-75

MISSISSIPPI
 BOARD OF WATER COMMISSIONERS
 416 North State Street
 Jackson, Mississippi 39201

WATER WELL DRILLERS LOG


Nov 3, 1975 19 McILWAIN WATER WELL SERVICE WAYNE
 date well completed RT. 2 BOX 37 county well located
 WAYNESBORO, MISS. 39367

LANDOWNER:	description of formations encountered	from	to
MR. CLEVELAND BROWN	Red Sandy Clay	0	5
RT 2 WAYNESBORO, Miss. (mailing address)	Red Sand	5	15
WELL LOCATION: sec. 31 T 9 N R 6 E 13P 1/8 W	Fine sand, some clay	15	40
1 miles NE of W'BORO (distance) (direction) (nearest town)	clay	40	62
WELL PURPOSE: HOME (home, irrigation, municipal, industrial)	Sand	62	68
WELL COMPLETION DATA:			
(1) diameter (inches) 2"			
(2) total depth (feet) 68'			
(3) static water level (feet) 23' below top of ground.			
(4) casing PVC 63' (material) (depth)			
2" If telescope see back. (size)			
(5) screen 5' 63' (length) (depth to top)			
2" PVC (size) (material)			
(6) pump 3/4 10 (HP) (yield gpm)			
220 AC (type power)			
(7) electric log no (yes or no)			
(organization running log)			
(8) how well bottom plugged			
DRILLERS REMARKS:			

NOV 25 1975
 MISS. Bd. OF WATER COMMISSIONERS

If well telescopes please sketch and show depths.

GROUND LEVEL

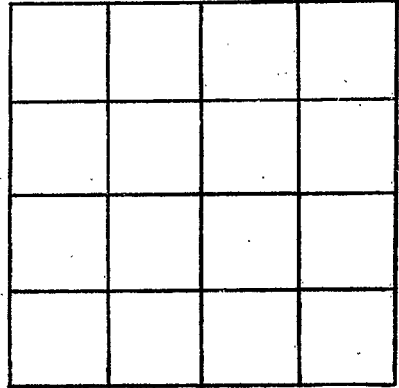

SECTION _____

Please indicate well location X.

ADDITIONAL INFORMATION

If more than one screen, show locations of each on sketch.