

Wayne  
 J 2002  
 3/26/76

MISSISSIPPI  
 BOARD OF WATER COMMISSIONERS  
 416 North State Street  
 Jackson, Mississippi 39201

WATER WELL DRILLERS LOG


McILWAIN WATER WELL SERVICE Wayne

MARCH 26, 1976  
 date well completed

Rt firm name BOX 37  
 WAYNESBORO MISS 39367

county well located


LANDOWNER:	description of formations encountered	from	to
ANDY BEARD RTC WAYNESBORO, MISS. (mailing address)			
WELL LOCATION:	Mixed clay	6	14
sec. 17 T 9 N R 6 <small>5</small> <small>W</small>	Sand (Red)	14	40
0 miles N of W'BORO (distance) (direction) (nearest town)	White Sand	40	55
WELL PURPOSE: HOME (home, irrigation, municipal, industrial)			
WELL COMPLETION DATA:			
(1) diameter (inches) 2"			
(2) total depth (feet) 55'			
(3) static water level (feet) 40' below top of ground.			
(4) casing PVC 51' (material) (depth)			
2" If telescope see back. (size)			
(5) screen 4' 51' (length) (depth to top)			
2" PVC DOB (size) (material)			
(6) pump 2 10 (HP) (yield gpm)			
220 AC (type power)			
(7) electric log 770 (yes or no)			
(organization running log)			
(8) how well bottom plugged			
DRILLERS REMARKS:			

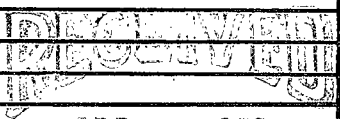

APR 20 1976

If well telescopes please sketch and show depths.

GROUND LEVEL

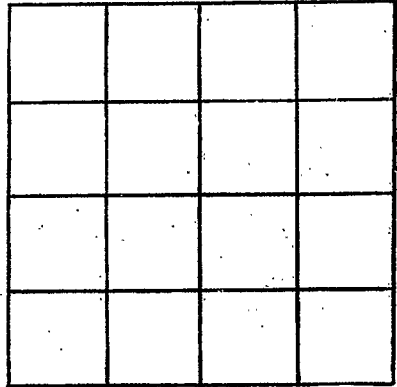

SECTION \_\_\_\_\_

Please indicate well location X.

ADDITIONAL INFORMATION

If more than one screen, show locations of each on sketch.