

Wayne
 T 2003
 4-13-76

MISSISSIPPI
 BOARD OF WATER COMMISSIONERS
 416 North State Street
 Jackson, Mississippi 39201

WATER WELL DRILLERS LOG

April 13 1976 Proctor Drilling Wayne
 date well completed firm name county well located


LANDOWNER:	description of formations encountered	from	to
<u>Mr. D.C. Johnson Jr.</u>	<u>red sand</u>	<u>0</u>	<u>4.5</u>
<u>with Mainesboro</u> (mailing address)	<u>red sand</u>	<u>4.5</u>	<u>6.5</u>
WELL LOCATION:	<u>red sand</u>	<u>6.5</u>	<u>7.2</u>
sec <u>20</u> T <u>9</u> N R <u>6</u> E S W	<u>red sand</u>	<u>7.2</u>	<u>7.9</u>
<u>3</u> miles <u>N</u> of <u>Yippsville</u>	<u>blue clay</u>	<u>7.9</u>	<u>10.6</u>
(distance) (direction) (nearest town)	<u>blue clay</u>	<u>10.6</u>	<u>11.4</u>
WELL PURPOSE: <u>home</u> (home, irrigation, municipal, industrial)	<u>blue sand with gravel</u>	<u>11.4</u>	<u>17.0</u>
WELL COMPLETION DATA:			
(1) diameter (inches) <u>2"</u>			
(2) total depth (feet) <u>17.0</u>			
(3) static water level (feet) <u>13.1</u> below/above top of ground.			
(4) casing <u>steel</u> <u>-11.4</u> (material) (depth)			
<u>2'</u> If telescope see back. (size)			
(5) screen <u>none</u> <u>none</u> (length) (depth to top)			
(size) (material)			
(6) pump <u>2</u> <u>6</u> (HP) (yield gpm)			
<u>elec</u> (type power)			
(7) electric log <u>none</u> (yes or no)			
(organization running log)			
(8) how well bottom plugged			
DRILLERS REMARKS:			

APR 19 1976

MISS. BD. OF WATER COMMISSIONERS

If well telescopes please sketch and show depths.

GROUND LEVEL

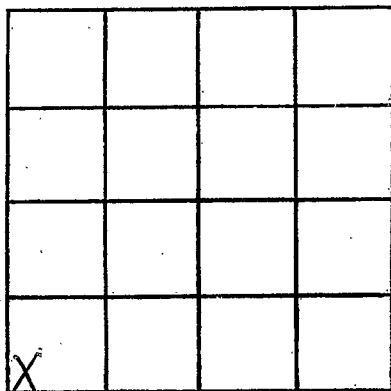

SECTION 20

Please indicate well location X.

ADDITIONAL INFORMATION

If more than one screen, show locations of each on sketch.