

WAYNE

J 2000

4-26-76

MISSISSIPPI
 BOARD OF WATER COMMISSIONERS
 416 North State Street
 139 Jackson, Mississippi 39201

WATER WELL DRILLERS LOG

April 26, 1976
date well completed

McILWAIN WATER WELL SERVICE

Wayne

RT. #1 BOX 37

county well located

WAYNESBORO, MISS. 39367

LANDOWNER:

Arthur Blakley

Rt 4 Waynesboro, Miss.
(mailing address)

description of formations encountered

from

to

Red Clay

0 12

Coarse Sand

12 82

WELL LOCATION:

sec. 17 T 9 N R 6 E

5 miles NE of W'BORO
(distance) (direction) (nearest town)

WELL PURPOSE: HOME
(home, irrigation, municipal, industrial)

WELL COMPLETION DATA:

- (1) diameter (inches) 2"
- (2) total depth (feet) 82'
- (3) static water level (feet) 54' below top of ground.
- (4) casing PVC 78'
(material) (depth)
2" if telescope see back.
(size)
- (5) screen 4' 78'
(length) (depth to top)
2" PVC
(size) (material)
- (6) pump 1 9
(HP) (yield gpm)
110 AC
(type power)
- (7) electric log No
(yes or no)

(organization running log)

(8) how well bottom plugged


DRILLERS REMARKS:

JUN 1 1976

MISS. Bd. of Water Comm.

If well telescopes please
sketch and show depths.

GROUND LEVEL

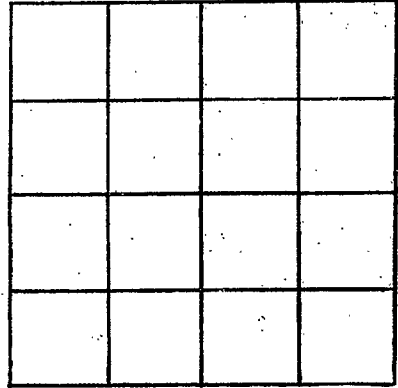

SECTION _____

Please indicate well location X.

ADDITIONAL INFORMATION

If more than one screen,
show locations of each on sketch.