

WAYNE
 J 2000
 5-19-76

MISSISSIPPI
 BOARD OF WATER COMMISSIONERS
 416 North State Street
 Jackson, Mississippi 39201

WATER WELL DRILLERS LOG

McILWAIN WATER WELL SERVICE *Wayne*

May 19, 1976
 date well completed

RT firm name BOX 37
 WAYNESBORO, MISS 39367

county well located

LANDOWNER:
JAMES M^cINNIS
Rt 2 WAYNESBORO, MISS.
 (mailing address)

description of formations encountered	from	to
<i>Red Clay</i>	<i>0</i>	<i>15</i>
<i>Sand</i>	<i>15</i>	<i>75</i>
<i>yellow Clay</i>	<i>75</i>	<i>85</i>
<i>Blue Clay</i>	<i>85</i>	<i>105</i>
<i>Limy Rock + Clay</i>	<i>105</i>	<i>120</i>
<i>Brown Clay</i>	<i>120</i>	<i>142</i>
<i>Honeycomb Rock</i>	<i>142</i>	<i>170</i>

WELL LOCATION:
 sec *23* T *9* N ? R *6*
7 miles *NE* of *W'BORO*
 (distance) (direction) (nearest town)

WELL PURPOSE: *Home*
 (home, irrigation, municipal, industrial)


- WELL COMPLETION DATA:
- (1) diameter (inches) *2"*
 - (2) total depth (feet) *170'*
 - (3) static water level (feet) *132* below top of ground.
 - (4) casing *PVC* *145'*
 (material) (depth)
2" if telescope see back.
 (size)
 - (5) screen *NONE*
 (length) (depth to top)
 (size) (material)
 - (6) pump *2* *6*
 (HP) (yield gpm)
220 AC
 (type power)
 - (7) electric log *NO*
 (yes or no)
 (organization running log)
 - (8) how well bottom plugged

DRILLERS REMARKS:

MAY 16 1976

If well telescopes please
sketch and show depths.

GROUND LEVEL

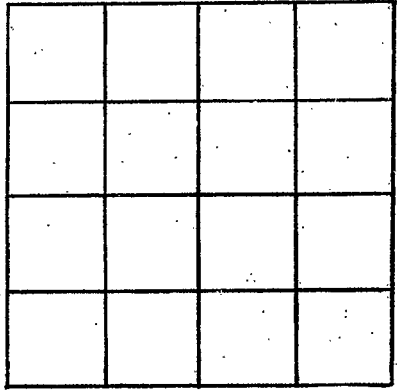

SECTION _____

Please indicate well location X.

ADDITIONAL INFORMATION

If more than one screen,
show locations of each on sketch.