

WAYNE
 J 2007
 6-4-76

MISSISSIPPI
 BOARD OF WATER COMMISSIONERS
 416 North State Street
 Jackson, Mississippi 39201

13P WATER WELL DRILLERS LOG
 MCILWAIN WATER WELL SERVICE

JUNE 4, 1976
 date well completed

RT. 2, BOX 37

WAYNE

WAYNESBORO, MISS. 39367

county well located


LANDOWNER:	description of formations encountered	from	to
HOWARD HOLIFIELD	Red Clay	0	10
RT 2 Waynesboro, Miss. (mailing address)	Sand & Clay	10	50
WELL LOCATION: sec. 22 T 9 N R 6 W 6 miles NE of W BORO (distance) (direction) (nearest town)	Sand	50	62
WELL PURPOSE: Home (home, irrigation, municipal, industrial)			
WELL COMPLETION DATA: (1) diameter (inches) 2" (2) total depth (feet) 62' (3) static water level (feet) 17' below top of ground. (4) casing PVC 54' (material) (depth) 2" (size) If telescope see back. (5) screen 8' 54' (length) (depth to top) 2" PVC 008 (size) (material) (6) pump 3/4 8 (HP) (yield gpm) 110 AC (type power) (7) electric log No (yes or no) (organization running log) (8) how well bottom plugged			
DRILLERS REMARKS:			

RECEIVED

JUL 14 1976

If well telescopes please sketch and show depths.

GROUND LEVEL

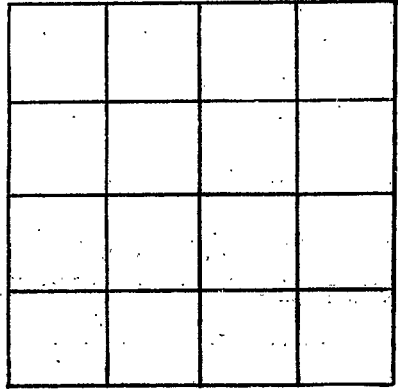

SECTION _____

Please indicate well location X.

ADDITIONAL INFORMATION

If more than one screen, show locations of each on sketch.