

Wayne  
 J. J. J. J.  
 7/9/76

MISSISSIPPI  
 BOARD OF WATER COMMISSIONERS  
 416 North State Street  
 Jackson, Mississippi 39201

WATER WELL DRILLERS LOG

McILWAIN WATER WELL SERVICE

July 9, 1976  
 date well completed

RT. 2 BOX 27  
 firm name  
 WAYNESBORO, MISS. 39367

Wayne  
 county well located

LANDOWNER:	description of formations encountered	from	to
Mr. Bobby Sims	Red Clay	0	5
Rt 2 Waynesboro, Miss. (mailing address)	Red Sand	5	16
WELL LOCATION: sec. 22 T 9 N R 6 E 6 miles NE of Waynesboro (distance) (direction) (nearest town)	Clay	16	23
	Sand	23	44
WELL PURPOSE: Home (home, irrigation, municipal, industrial)			
WELL COMPLETION DATA:			
(1) diameter (inches) 2"			
(2) total depth (feet) 44'			
(3) static water level (feet) 27' below top of ground.			
(4) casing PVC 40' (material) (depth) 2" If telescope see back. (size)			
(5) screen 4' 40' (length) (depth to top) 2" PVC (size) (material)			
(6) pump 1 12 (HP) (yield gpm) 220 AC (type power)			
(7) electric log no (yes or no)			
(organization running log)			
(8) how well bottom plugged			
DRILLERS REMARKS:			


RECEIVED

AUG 18 1976

MISS. BD. OF WATER COMMISSIONERS

If well telescopes please sketch and show depths.

GROUND LEVEL

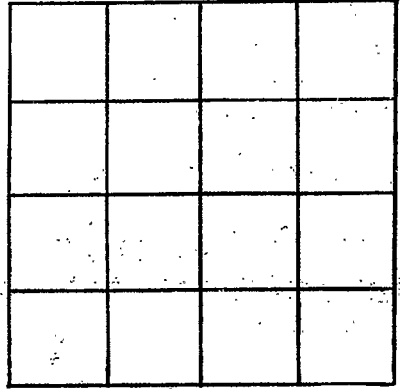

SECTION \_\_\_\_\_

Please indicate well location X.

ADDITIONAL INFORMATION

A series of horizontal lines for entering additional information, located below the 'ADDITIONAL INFORMATION' header.

If more than one screen, show locations of each on sketch.