

Wayne
 J 2010
 8-6-76

MISSISSIPPI
 BOARD OF WATER COMMISSIONERS
 416 North State Street
 Jackson, Mississippi 39201

WATER WELL DRILLERS LOG

Aug 6 1976 ^{13P} Port Drilling & Log Wayne
 date well completed firm name county well located

LANDOWNER: Jimmy Blaney
 1405 Ployed St.
 Waynesboro Miss
 (mailing address)

WELL LOCATION:
 sec. 18 T-9 N R-6 S
 4 miles N of Waynesboro
 (distance) (direction) (nearest town)

WELL PURPOSE: Home
 (home, irrigation, municipal, industrial)

- WELL COMPLETION DATA:
- (1) diameter (inches) 4
 - (2) total depth (feet) 156
 - (3) static water level (feet) 123 (below above top of ground)
 - (4) casing steel 121' (material) (depth)
 4" (size) if telescope see back.
 - (5) screen none used (length) (depth to top)
 - (6) pump 1 sub 20 (HP) (yield gpm)
 elec. (type power)
 - (7) electric log no (yes or no)
 - (organization running log)
 - (8) how well bottom plugged open

description of formations encountered	from to	
sand & clay	0	45
sand & clay	45	57
clay red sand	57	72
red clay	72	76
thin rock		76
blue clay	76	85
rock strata	85	102
blue clay	102	120
Vicksburg	120	156

lost circulation at 130'
 135' 1/4" down pipe


DISCONTINUED
 AUG 9 - 1976

MISS. Bd. OF WATER COMMISSIONERS

DRILLERS REMARKS:

If well telescopes please sketch and show depths.

GROUND LEVEL

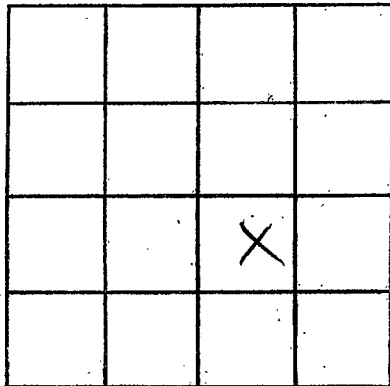

SECTION 18

Please indicate well location X.

ADDITIONAL INFORMATION

A series of horizontal lines for writing additional information, starting below the 'ADDITIONAL INFORMATION' header and extending to the bottom of the page.

If more than one screen, show locations of each on sketch.