

Wayne
 J 2011
 9/24/76

MISSISSIPPI
 BOARD OF WATER COMMISSIONERS
 416 North State Street
 Jackson, Mississippi 39201

WATER WELL DRILLERS LOG

Sept 24 1976 ^{13P} Porter Drilling & Equip. Wayne
 (date well completed) (firm name) (county well located)

LANDOWNER: <u>Guy Walker</u>	description of formations encountered	from	to
<u>At 2 Waynesboro Miss</u> (mailing address)	<u>red clay & sand</u>	<u>0</u>	<u>10</u>
WELL LOCATION: sec. <u>31</u> T <u>9</u> N R. <u>6</u> E 1 miles <u>NE</u> of <u>Waynesboro</u> (distance) (direction) (nearest town)	<u>sand & clay</u>	<u>10</u>	<u>60</u>
WELL PURPOSE: <u>home</u> (home, irrigation, municipal, industrial)	<u>fine sand &</u>	<u>60</u>	<u>72</u>
WELL COMPLETION DATA:	<u>stopped on clay</u>		
(1) diameter (inches) <u>2</u>	<u>4' 2" 7 slot S.S. with</u>		
(2) total depth (feet) <u>72'</u>	<u>shell trap above &</u>		
(3) static water level (feet) <u>45</u> (below above top of ground.)	<u>1 1/4" back wash valve</u>		
(4) casing <u>P.V.C. 68'</u> (material) (depth)	<u>on end.</u>		
2" (size) If telescope see back.	<u>62' 1" P.V.C. drop pipe</u>		
(5) screen <u>4' 68'</u> (length) (depth to top)			
2" (size) <u>7 slot S.S.</u> (material)			
(6) pump <u>3/4</u> <u>5</u> (HP) (yield gpm)			
<u>elec.</u> (type power)			
(7) electric log <u>no</u> (yes or no)			
(organization running log)			
(8) how well bottom plugged <u>back wash valve</u>			
DRILLERS REMARKS:			


RECEIVED

NOV - 3 1976

MISS. Bd. OF WATER COMM.

If well telescopes please sketch and show depths.

GROUND LEVEL

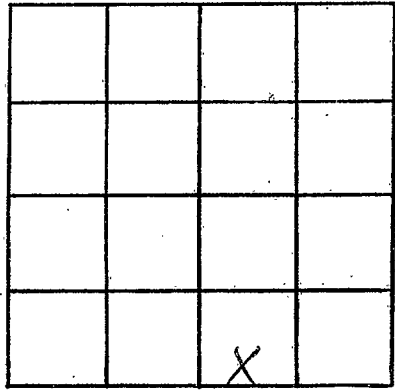

SECTION 31

Please indicate well location X.

ADDITIONAL INFORMATION

If more than one screen,
show locations of each on sketch.