

Wayne
 J 2014
 1-13-77

MISSISSIPPI
 BOARD OF WATER COMMISSIONERS
 416 North State Street
 Jackson, Mississippi 39201

WATER WELL DRILLERS LOG

McLWAIN WATER WELL SERVICE

JAN 13 1977
 date well completed

RT. 2 BOX 37
 WAYNESBORO, MISS. 39367

Wayne
 county well located


LANDOWNER:	description of formations encountered	from	to
Waynesboro, Miss. (mailing address)			
Mr. T. Jordan	Red Clay	0	8
WELL LOCATION:	Sand	8	12
sec. 33 T 9 N R 6 W	Clay	12	16
4 miles E of W'boro	Fine Sand & Clay	16	25
(distance) (direction) (nearest town)	Sand	25	45
WELL PURPOSE: HOME (home, irrigation, municipal, industrial)			
WELL COMPLETION DATA:			
(1) diameter (inches) 2"			
(2) total depth (feet) 45'			
(3) static water level (feet) 35' below top of ground.			
(4) casing PVC 40' (material) (depth)			
(size) If telescope see back.			
(5) screen 5' 40' (length) (depth to top)			
2" PVC (size) (material)			
(6) pump 1/2 5 (HP) (yield gpm)			
110 AC (type power)			
(7) electric log No (yes or no)			
(organization running log)			
(8) how well bottom plugged			
DRILLERS REMARKS:			

RECEIVED
 JAN 21 1977

MISS. Bd. OF WATER COMMISSIONERS

If well telescopes please sketch and show depths.

GROUND LEVEL

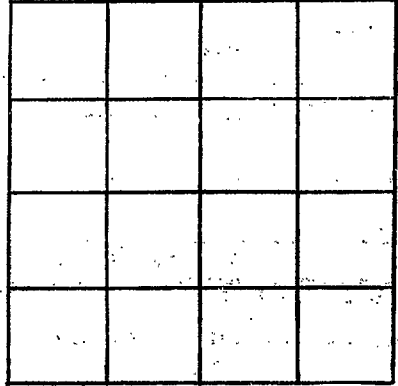

SECTION _____

Please indicate well location X.

ADDITIONAL INFORMATION

If more than one screen, show locations of each on sketch.