

Wayne
J 2015
3/9/77

MISSISSIPPI
 BOARD OF WATER COMMISSIONERS
 416 North State Street
 13P Jackson, Mississippi 39201

WATER WELL DRILLERS LOG

March 9 1977 McILWAIN WATER WELL SERVICE Wayne
 date well completed RT-firm name county well located
 WAYNESBORO MISS 39367

LANDOWNER:
Mr. W. M. Allen
Waynesboro Miss
 (mailing address)

description of formations encountered	from	to
<u>Red Clay</u>	<u>0</u>	<u>8</u>
<u>Red Sand</u>	<u>8</u>	<u>22</u>
<u>Clay</u>	<u>22</u>	<u>32</u>
<u>Sand</u>	<u>32</u>	<u>77</u>

WELL LOCATION:
 sec. 29 T. 9 N. R. 6 W.
4 miles NE of Wboro
 (distance) (direction) (nearest town)

WELL PURPOSE: Home
 (home, irrigation, municipal, industrial)


- WELL COMPLETION DATA:
- (1) diameter (inches) 2"
 - (2) total depth (feet) 77'
 - (3) static water level (feet) 61' below top of ground.
 - (4) casing PVC 72'
 (material) (depth)
2"
 (size) if telescope see back.
 - (5) screen 5' 72'
 (length) (depth to top)
2" PVC .008
 (size) (material)
 - (6) pump 3/4 5
 (HP) (yield gpm)
110 AC
 (type power)
 - (7) electric log No
 (yes or no)
- (organization running log)
- (8) how well bottom plugged

DRILLERS REMARKS:

RECEIVED
 MAR 14 1977
 MISS. Bd. OF WATER COMMISSIONERS

If well telescopes please
sketch and show depths.

GROUND LEVEL

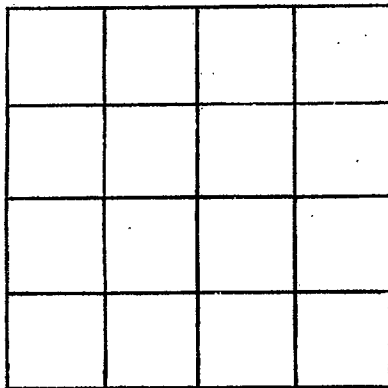

SECTION _____

Please indicate well location X.

ADDITIONAL INFORMATION

If more than one screen,
show locations of each on sketch.