

WAYNE  
 J 2016  
 4/20/77

MISSISSIPPI  
 BOARD OF WATER COMMISSIONERS  
 416 North State Street  
 Jackson, Mississippi 39201

WATER WELL DRILLERS LOG

April 20  
 date well completed

1977 GILWAIN WATER WELL SERVICE Wayne  
 RT. 2, BOX 37 county well located


LANDOWNER:	description of formations encountered	from	to
Jammy Boplin Waynesboro Miss (mailing address)	Red Clay	0	12
WELL LOCATION:	Red Sand	12	44
sec. 32 T 9 N R 6 W 2 miles NE of W'boro (distance) (direction) (nearest town)	Sand & Clay	44	58
WELL PURPOSE: Home (home, irrigation, municipal, industrial)	Sand	58	73
WELL COMPLETION DATA:			
(1) diameter (inches) 2"			
(2) total depth (feet) 73'			
(3) static water level (feet) 46' below top of ground.			
(4) casing PVC 68' (material) (depth) 2" if telescope see back. (size)			
(5) screen 5' 68' (length) (depth to top) 2" PVC 008 (size) (material)			
(6) pump 1 9 (HP) (yield gpm) 110 AC (type power)			
(7) electric log No (yes or no)  (organization running log)			
(8) how well bottom plugged			
DRILLERS REMARKS:			

RECEIVED  
 MAY 31 1977

MISS. BD. OF WATER COMMISSIONERS

If well telescopes please sketch and show depths.

GROUND LEVEL

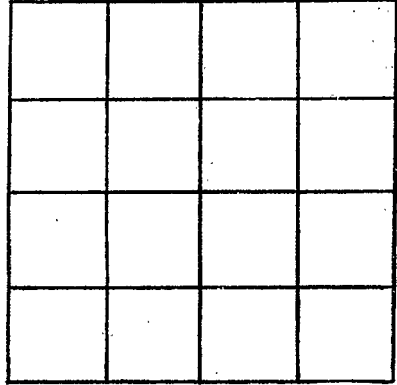

SECTION \_\_\_\_\_

Please indicate well location X.

ADDITIONAL INFORMATION

If more than one screen, show locations of each on sketch.