

Wayne
 J 2017
 7-5-77

MISSISSIPPI
 BOARD OF WATER COMMISSIONERS
 416 North State Street
 Jackson, Mississippi 39201

WATER WELL DRILLERS LOG

July 5 1977
 date well completed

MOLWAIN WATER WELL SERVICE

Wayne
 county well located

RT. 4, Box 3A

WAYNESBORO, MISS. 39365


LANDOWNER:	description of formations encountered	from	to
Sarah Sims			
Waynesboro Miss. (mailing address)	Red Sand	8	28
WELL LOCATION:	Clay	28	32
sec. <u>23</u> T <u>9</u> N R. <u>6</u> E S W	Sand + Clay	32	45
<u>5</u> miles <u>NE</u> of <u>Waynesboro</u> (distance) (direction) (nearest town)	Sand	45	62
WELL PURPOSE: <u>home</u> (home, irrigation, municipal, industrial)			
WELL COMPLETION DATA:			
(1) diameter (inches) <u>2"</u>			
(2) total depth (feet) <u>62'</u>			
(3) static water level (feet) <u>47'</u> below top of ground.			
(4) casing <u>PVC</u> , <u>57'</u> (material) (depth)			
<u>2"</u> (size) if telescope see back.			
(5) screen <u>5'</u> , <u>57'</u> (length) (depth to top)			
<u>2"</u> , <u>PVC</u> , <u>.008</u> (size) (material)			
(6) pump <u>3/4</u> , <u>9</u> (HP) (yield gpm)			
<u>110 AC</u> (type power)			
(7) electric log <u>No</u> (yes or no)			
(organization running log)			
(8) how well bottom plugged			
DRILLERS REMARKS:			

RECEIVED
 JUL 22 1977

MISS. Bd. OF WATER COMMISSIONERS

If well telescopes please sketch and show depths.

GROUND LEVEL

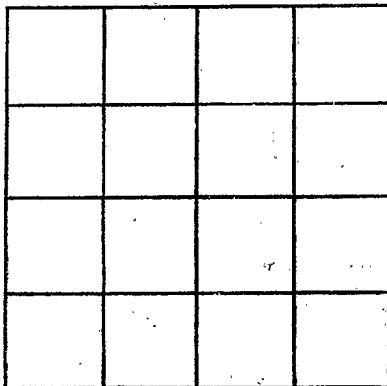

SECTION _____

Please indicate well location X.

ADDITIONAL INFORMATION

If more than one screen,
show locations of each on sketch.