

Wayne  
 J 2018  
 9-8-77

MISSISSIPPI  
 BOARD OF WATER COMMISSIONERS  
 416 North State Street  
 Jackson, Mississippi 39201

13P

WATER WELL DRILLERS LOG

McILWAIN WATER WELL SERVICE

Sept 8

1977

date well completed

RT. 2 BOX 371  
 from home

WAYNESBORO MISS 39367

Wayne  
 county well located


| LANDOWNER:   | description of formations encountered | from     | to       |
|--|---------------------------------------|----------|----------|
| Bruce McIlwain<br>Waynesboro Miss<br>(mailing address)   | Red Clay<br>Sand                      | 0<br>8   | 8<br>35  |
| WELL LOCATION:<br>sec. 8 T. 9 N R. 6 E<br>6 miles NE of Waynesboro<br>(distance) (direction) (nearest town)  | Sand + Clay<br>Sand                   | 35<br>48 | 48<br>66 |
| WELL PURPOSE: Home<br>(home, irrigation, municipal, industrial)  |                                       |          |          |
| WELL COMPLETION DATA:<br>(1) diameter (inches) 2"<br>(2) total depth (feet) 66'<br>(3) static water level (feet) 37' below top of ground.<br>(4) casing PVC 56'<br>(material) (depth)<br>2" if telescope see back.<br>(size)<br>(5) screen 10' 56'<br>(length) (depth to top)<br>2" PVC 208<br>(size) (material)<br>(6) pump 1 15<br>(HP) (yield gpm)<br>220 AC<br>(type power)<br>(7) electric log No<br>(yes or no)<br><br>(organization running log)<br><br>(8) how well bottom plugged |                                       |          |          |
| DRILLERS REMARKS:  |                                       |          |          |

RECEIVED  
 SEP 19 1977

MISS. BO. OF WATER COMMISSIONERS

If well telescopes please sketch and show depths.

GROUND LEVEL

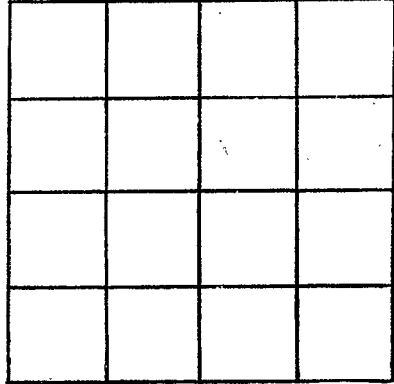

SECTION \_\_\_\_\_

Please indicate well location X.

ADDITIONAL INFORMATION

If more than one screen, show locations of each on sketch.