

Wayne
J 209
10/5/77

MISSISSIPPI
BOARD OF WATER COMMISSIONERS
416 North State Street
Jackson, Mississippi 39201

WATER WELL DRILLERS LOG
McILWAIN WATER WELL SERVICE

Oct 5
date well completed

1977 RT. 2, BOX 27
WAYNESBORO, MISS. 39367

Wayne
county well located

LANDOWNER:
Bob Cooley
Waynesboro, Miss.
(mailing address)

description of formations encountered	from	to
Red SANDY CLAY	0	8
Red SAND	8	15

WELL LOCATION:
sec. 28 T. 9 N R. 6 E
S W
5 miles NE of W'boro
(distance) (direction) (nearest town)

SAND	15	58
------	----	----

WELL PURPOSE: Home
(home, irrigation, municipal, industrial)

WELL COMPLETION DATA:
(1) diameter (inches) 2"
(2) total depth (feet) 58'
(3) static water level (feet) 37' below above top of ground.
(4) casing PVC 53' (material) (depth)
2" (size) if telescope see back.
(5) screen 5' 53' (length) (depth to top)
2" PVC (size) (material)
(6) pump 1 12 (HP) (yield gpm)
110 AC (type power)
(7) electric log No (yes or no)
(organization running log)
(8) how well bottom plugged

DRILLERS REMARKS:


RECEIVED

NOV 11 1977

MISS. BD OF WATER COMMISSIONERS

If well telescopes please sketch and show depths.

GROUND LEVEL

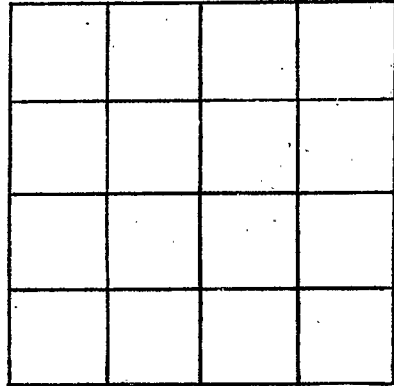

SECTION _____

Please indicate well location X.

ADDITIONAL INFORMATION

If more than one screen, show locations of each on sketch.