

WAYNE

MISSISSIPPI
BOARD OF WATER COMMISSIONERS
416 North State Street
Jackson, Mississippi 39201

J 2030

5-11-78

WATER WELL DRILLERS LOG SERVICE
McLWAIN WATER WELL SERVICE

May 11

19 78

RT. 2, BOX 37

WAYNE

date well completed

WAYNESBORO, MISS. 39367

county well located

LANDOWNER:	description of formations encountered	from	to
Grady Windham Waynesboro Ms (mailing address)			
WELL LOCATION:	Mixed Clay	5	15
sec. 32 T 9 N R 6 E	Red Sand	15	30
(4) miles NE of W'boro	Sand	30	55
(distance) (direction) (nearest town)	Sand + Clay	55	80
WELL PURPOSE: Home			
(home, irrigation, municipal, industrial)			
WELL COMPLETION DATA:			
(1) diameter (inches) 2"			
(2) total depth (feet) 80'			
(3) static water level (feet) 57' below top of ground.			
(4) casing PVC 70' (material) (depth)			
2" (size) If telescope see back.			
(5) screen 10' 70' (length) (depth to top)			
2" PVC.008 (size) (material)			
(6) pump 1 4 1/2 (HP) (yield gpm)			
220 AC (type power)			
(7) electric log No (yes or no)			
(organization running log)			
(8) how well bottom plugged			
DRILLERS REMARKS: Water Sand Restricted by Clay Content			


RECEIVED

JUN 12 1978

MISS. BD. OF WATER

If well telescopes please sketch and show depths.

GROUND LEVEL

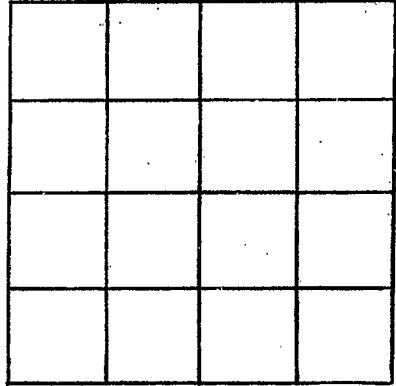

SECTION _____

Please indicate well location X.

ADDITIONAL INFORMATION

If more than one screen,
show locations of each on sketch.