

WAYNE
J 2021
12-13-78

**MISSISSIPPI
BOARD OF WATER COMMISSIONERS**
416 North State Street
Jackson, Mississippi 39201

WATER WELL DRILLERS LOG

McILWAIN WATER WELL SERVICE

Dec 13 1978 date well completed RT. firm name BOX 37 WAYNESBORO MISS. 39367 WAYNE county well located

LANDOWNER:	description of formations encountered	from	to
Jimmy Triggs Waynesboro Miss. (mailing address)			
WELL LOCATION: sec. 8 T. 9 N R. 6 E 6 miles NE of W'boro (distance) (direction) (nearest town)	SAND	15	23
WELL PURPOSE: Home (home, irrigation, municipal, industrial)	White SAND	23	30
WELL COMPLETION DATA:	Red + White SAND	30	34
(1) diameter (inches) 2"	Coarse White SAND	34	44
(2) total depth (feet) 61'	White SAND + Clay	44	48
(3) static water level (feet) 53' below top of ground.	Coarse SAND + Clay	48	55
(4) casing PVC 56' (material) (depth) 2" (size) if telescope see back.	Coarse Med. SAND	55	61
(5) screen 5' (length) 56' (depth to top) 2" (size) PVC .008 (material)			
(6) pump 1 (HP) 8 (yield gpm) 110 AC (type power)			
(7) electric log No (yes or no)			
(organization running log)			
(8) how well bottom plugged			


RECEIVED
JAN 16 1978

MISS. BD. OF WATER COMM.

DRILLERS REMARKS:

If well telescopes please sketch and show depths.

GROUND LEVEL

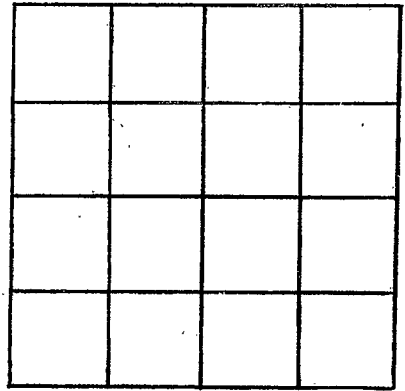

SECTION _____

Please indicate well location X.

ADDITIONAL INFORMATION

If more than one screen, show locations of each on sketch.