

WAYNE
 J 2023
 1-18-79

MISSISSIPPI
 BOARD OF WATER COMMISSIONERS
 416 North State Street
 Jackson, Mississippi 39201

WATER WELL DRILLERS LOG

Jan 18 1979 date well completed
 Boots Drilling & Log firm name
 Wayne county well located

LANDOWNER:	description of formations encountered	from	to
Hattie Joe Hutton 1314 Highland Dr Waynesboro Miss. (mailing address)	sand & clay clay sand slight on rock	0	31
		31	38
		38	56

WELL LOCATION:
 sec 29 T 9 N R 6 E
 2 1/2 miles NE of Waynesboro 4.5' 1" P.V.C. drop pipe
 (distance) (direction) (nearest town)

WELL PURPOSE: home
 (home, irrigation, municipal, industrial)


- WELL COMPLETION DATA:
- diameter (inches) 2'
 - total depth (feet) 56'
 - static water level (feet) 33' below top of ground.
 - casing P.V.C. 51' (material) (depth)
 2' (size) if telescope see back.
 - screen 5' 51' (length) (depth to top)
 2' (size) balut S.S. (material)
 - pump 1 (HP) 12 (yield gpm)
 elec (type power)
 - electric log no (yes or no)
- (organization running log)
- (8) how well bottom plugged
 2' back wash valve

DRILLERS REMARKS:

Miss. Board of Water Comm.
 8
 FEB 8 1979
 RECEIVED

If well telescopes please sketch and show depths.

GROUND LEVEL

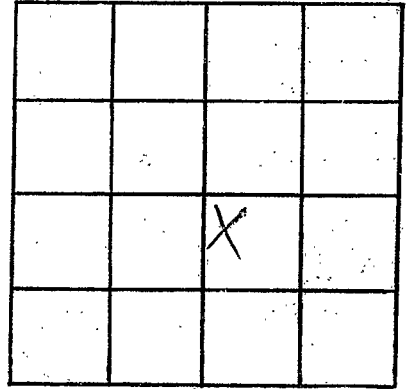

SECTION 29

Please indicate well location X.

ADDITIONAL INFORMATION

If more than one screen, show locations of each on sketch.