

WAYNE
 J 2024
 7-13-79

MISSISSIPPI
 BOARD OF WATER COMMISSIONERS
 416 North State Street
 Jackson, Mississippi 39201

WATER WELL DRILLERS LOG
 McILWAIN WATER WELL SERVICE

7-13-1979 date well completed
 RT. 2, BOX 37 Wayne
 WAYNE MISS. 39367 county well located

| LANDOWNER: | description of formations encountered | from | to |
|---|---------------------------------------|-------|-------|
| George Russell | Red Clay | 0 | 6 1/2 |
| Waynesboro Miss (mailing address) | Red Sand | 6 1/2 | 23 |
| WELL LOCATION: | Med. Sand | 23 | 27 |
| sec. 23 T. 9 N R. 6 E 7 miles NE of Wilboro (distance) (direction) (nearest town) | Med - Fine Sand & Clay | 27 | 35 |
| WELL PURPOSE: Home (home, irrigation, municipal, industrial) | Med. White Sand | 35 | 40 |
| WELL COMPLETION DATA: | White Clay | 40 | 43 |
| (1) diameter (inches) 2" | Med White Sand | 43 | 50 |
| (2) total depth (feet) 50' | | | |
| (3) static water level (feet) 30" below top of ground. | | | |
| (4) casing PVC 45' (material) (depth) | | | |
| 2" if telescope see back. (size) | | | |
| (5) screen 5' 45' (length) (depth to top) | | | |
| 2" PVC (size) (material) | | | |
| (6) pump 1 8 (HP) (yield gpm) | | | |
| 220 AC (type power) | | | |
| (7) electric log No (yes or no) | | | |
| (organization running log) | | | |
| (8) how well bottom plugged | | | |
| DRILLERS REMARKS: | | | |


Miss. Board of Water Comm.

AUG 9 1979

RECEIVED

If well telescopes please sketch and show depths.

GROUND LEVEL

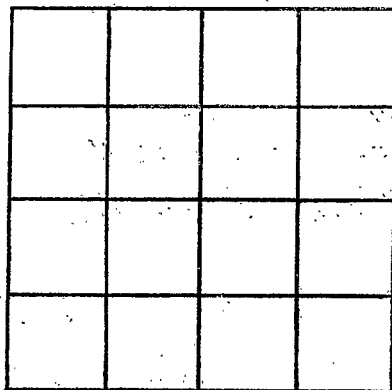

SECTION _____

Please indicate well location X.

ADDITIONAL INFORMATION

If more than one screen,
show locations of each on sketch.