

WAYNE
 J 2005
 7-27-79

MISSISSIPPI
 BOARD OF WATER COMMISSIONERS
 416 North State Street
 Jackson, Mississippi 39201

WATER WELL DRILLERS LOG

7-27 1979 date well completed
 McILWAIN WATER WELL SERVICE firm name
 Rt. 2, BOX 37 county well located
 Wayne

LANDOWNER:	description of formations encountered	from	to
Lane Taylor	Red Sand	0	2
Waynesboro Miss (mailing address)	Sand Rocks	2	2 1/2
WELL LOCATION: sec. 22 T 9 N R 6 E	Red Sand	2 1/2	10
8 miles NE of Wboro (distance) (direction) (nearest town)	White Sand	10	45
WELL PURPOSE: Home (home, irrigation, municipal, industrial)	Sand & Clay	45	53
WELL COMPLETION DATA:	Fine Sand	57	60
(1) diameter (inches) 2"	Med Sand	60	65
(2) total depth (feet) 65'			
(3) static water level (feet) 55' below top of ground.			
(4) casing PVC 59' (material) (depth)			
2" (size) if telescope see back.			
(5) screen 6' 59' (length) (depth to top)			
2" PVC 008 (size) (material)			
(6) pump 1 7 (HP) (yield gpm)			
220 AC (type power)			
(7) electric log No (yes or no)			
(organization running log)			
(8) how well bottom plugged			
DRILLERS REMARKS:			


Miss. Board of Water Comm.

AUG 9 1979

RECEIVED

If well telescopes please sketch and show depths.

GROUND LEVEL

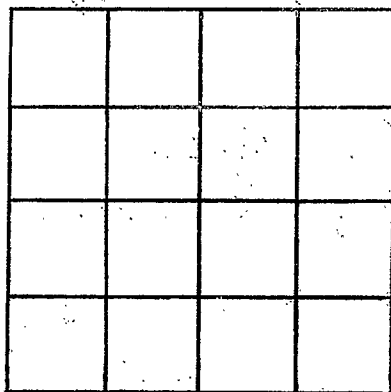

SECTION _____

Please indicate well location X.

ADDITIONAL INFORMATION

If more than one screen, show locations of each on sketch.