

MISSISSIPPI  
 BOARD OF WATER COMMISSIONERS  
 416 North State Street  
 Jackson, Mississippi 39201

WATER WELL DRILLERS LOG

W. W. W. W.  
J 2027  
6/12/80

June 12 1980 Porter Drilling Co Madison  
 date well completed firm name county well located

LANDOWNER: <u>Walter P. ...</u>	description of formations encountered	from	to
<u>212 W. ...</u>	<u>med clay &amp; sand</u>	<u>0</u>	<u>25</u>
(mailing address)	<u>clay</u>	<u>25</u>	<u>38</u>
WELL LOCATION:	<u>sand</u>	<u>38</u>	<u>47</u>
sec <u>22</u> T <u>9</u> N R <u>6</u> E	<u>clay</u>	<u>47</u>	<u>58</u>
<u>4</u> miles <u>NE</u> of <u>Dayton</u>	<u>sand some clay</u>	<u>58</u>	<u>63</u>
(distance) (direction) (nearest town)	<u>stagnant on clay</u>		
WELL PURPOSE: <u>home</u> (home, irrigation, municipal, industrial)			
WELL COMPLETION DATA:	<u>56" PVC deep pipe</u>		
(1) diameter (inches) <u>2"</u>			
(2) total depth (feet) <u>63'</u>			
(3) static water level (feet) <u>53'</u> <u>below</u> top of ground.			
(4) casing <u>PVC</u> , <u>58'</u> (material) (depth)			
<u>2"</u> (size) if telescope see back.			
(5) screen <u>5'</u> , <u>58'</u> (length) (depth to top)			
<u>2"</u> , <u>bolt</u> , <u>58'</u> (size) (material)			
(6) pump <u>1</u> , <u>8</u> (HP) (yield gpm)			
<u>elec.</u> (type power)			
(7) electric log <u>no</u> (yes or no)			
(organization running log)			
(8) how well bottom plugged <u>2' sand shale</u>			
DRILLERS REMARKS:			


MISSISSIPPI DEPARTMENT OF NATURAL RESOURCES  
 BUREAU OF LAND & WATER RESOURCES

JUN 20 1980

RECEIVED

If well telescopes please sketch and show depths.

GROUND LEVEL

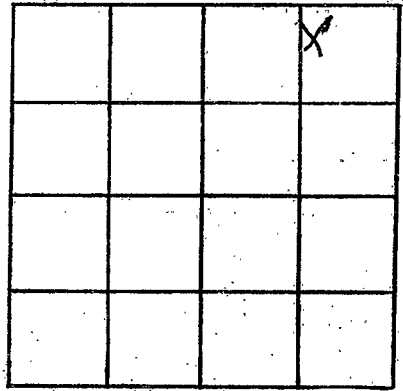

SECTION 22

Please indicate well location X.

ADDITIONAL INFORMATION

If more than one screen, show locations of each on sketch.