

MISSISSIPPI DEPARTMENT OF NATURAL RESOURCES

Bureau of Land and Water Resources

Southport Mall

P.O. Box 10631

Jackson, Mississippi 39209

WATER WELL DRILLERS LOG

<u>Wayne</u>
<u>J</u> <u>2030</u>
<u>7-12-80</u>

July 12 1980 date well completed  
 80 Porter Drilling & Log firm name  
 Wayne county well located

LANDOWNER:

David Walker

description of formations encountered

from

to

Lot 2  
Waynesboro Miss  
 (mailing address)

<u>clay &amp; sand</u>	<u>0</u>	<u>13</u>
<u>clay</u>	<u>13</u>	<u>40</u>
<u>sand</u>	<u>40</u>	<u>56</u>
<u>stop on clay</u>		

WELL LOCATION:

sec 31 T 9 (N) R 6 (W)  
1 miles N of Waynesboro  
 (distance) (direction) (nearest town)

42' 1" P.V.C drugi  
pjule

WELL PURPOSE:

home  
 (home, irrigation, municipal, industrial)

WELL COMPLETION DATA:

- (1) diameter (inches) 2"
- (2) total depth (feet) 56'
- (3) static water level (feet) 24' below above top of ground.
- (4) casing P.V.C 51'  
 (material) (depth)
- 2" if telescope see back.  
 (size)
- (5) screen 5' 51'  
 (length) (depth to top)
- 2" belet S.S.  
 (size) (material)
- (6) pump 1 12  
 (HP) (yield gpm)
- elec.  
 (type power)
- (7) electric log no  
 (yes or no)

(organization running log)

- (8) how well bottom plugged 2' sand shark


DRILLERS REMARKS:

DEPT. OF NATURAL RESOURCES  
 BUREAU OF LAND & WATER RESOURCES

SEP 24 1980  
 RECEIVED

If well telescopes please  
sketch and show depths.

GROUND LEVEL

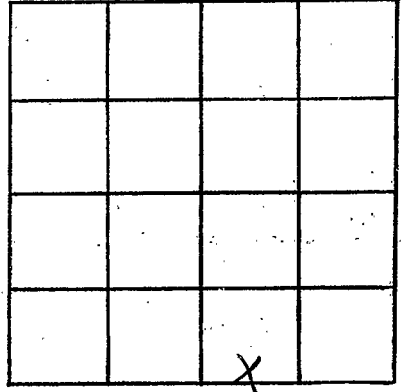

SECTION 31

Please indicate well location X.

ADDITIONAL INFORMATION

If more than one screen,  
show locations of each on sketch.