

MISSISSIPPI DEPARTMENT OF NATURAL RESOURCES

Bureau of Land and Water Resources

Southport Mall

P.O. Box 10631

Jackson, Mississippi 39209

WATER WELL DRILLERS LOG

Wayne
J 2031
2/4/81

Feb 4 1981 Porter Drilling & Log Wayne
date well completed firm name county well located

LANDOWNER: Lang Taylor
Pt 2 Waynesboro, Miss
(mailing address)

WELL LOCATION:
sec 22 T 9 N R 6 E
4 miles NE Waynesboro
(distance) (direction) (nearest town)

WELL PURPOSE: Home
(home, irrigation, municipal, industrial)

WELL COMPLETION DATA:
(1) diameter (inches) 2"
(2) total depth (feet) 165'
(3) static water level (feet) 133' (below above top of ground.)
(4) casing galv. 153'
(material) (depth)
2" if telescope see back.
(size)
(5) screen none used
(length) (depth to top)
(size) (material)
(6) pump 2 5
(HP) (yield gpm)
elec
(type power)
(7) electric log no
(yes or no)
(organization running log)
(8) how well bottom plugged open

description of formations encountered	from	to
sand	0	50
sand & clay	50	72
Clay	72	89
rocks	89	90
Clay	90	99
rocks	99	103
Clay	103	107
rocks	107	110
Clay	110	130
high brown rocks	130	155
white clay & rocks	155	165

147' 1 1/2' galv. dip pipe
132' 2" above bushing
21" below


DRILLERS REMARKS:

DEPT. OF NATURAL RESOURCES
BUREAU OF LAND & WATER RESOURCES

MAR - 6 1981
RECEIVED

If well telescopes please sketch and show depths.

GROUND LEVEL

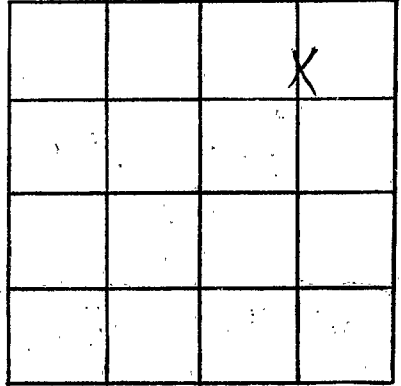

SECTION 22

Please indicate well location X.

ADDITIONAL INFORMATION

If more than one screen, show locations of each on sketch.