

MISSISSIPPI DEPARTMENT OF NATURAL RESOURCES

Bureau of Land and Water Resources

Southport Mall

P.O. Box 10631

Jackson, Mississippi 39209

WATER WELL DRILLERS LOG

Wayne
J 2032
3-23-81

March 23 1981 date well completed      Porter Drilling, Inc. firm name      Wayne county well located

LANDOWNER:	description of formations encountered	from	to
Charles Mc Dougle P.O. Box 214 Waynesboro, Miss. (mailing address)	also sand from gravel stratified clay	0	10
WELL LOCATION: sec 5 T 9 N R 60 E 5 miles NE Waynesboro (distance) (direction) (nearest town)	46' 1" P.V.C. casing		
WELL PURPOSE: home (home, irrigation, municipal, industrial)			
WELL COMPLETION DATA:			
(1) diameter (inches) 2"			
(2) total depth (feet) 53'			
(3) static water level (feet) 44' below top of ground			
(4) casing PVC (material), 48' (depth) 2" (size) if telescope see back.			
(5) screen 5' (length), 48' (depth to top) 2" (size), 6 slot S.S. (material)			
(6) pump 3/4 (HP), 5 (yield gpm) also (type power)			
(7) electric log no (yes or no) (organization running log)			
(8) how well bottom plugged 2' natural water			

DRILLERS REMARKS:


DEPT. OF NATURAL RESOURCES  
BUREAU OF LAND & WATER RESOURCES

MAY -7 1981

RECEIVED

If well telescopes please sketch and show depths.

GROUND LEVEL

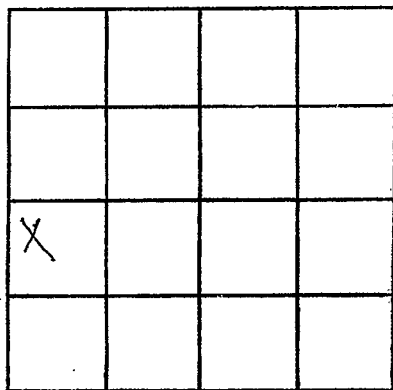

SECTION 22

Please indicate well location X.

ADDITIONAL INFORMATION

If more than one screen,  
show locations of each on sketch.