

MISSISSIPPI DEPARTMENT OF NATURAL RESOURCES

Bureau of Land and Water Resources

Southport Mall

P.O. Box 10631

Jackson, Mississippi 39209

WATER WELL DRILLERS LOG

WAYNE
J 2035
11-3-81

11-3-81 date well completed
McDonald & Hill firm name
Waynes county well located

LANDOWNER:
Coyt Baskett Church
(mailing address)

WELL LOCATION:
sec. 14 T. 9 N. R. 6 E.
8 miles S of Matherson
(distance) (direction) (nearest town)

WELL PURPOSE: home
(home, irrigation, municipal, industrial)

- WELL COMPLETION DATA:
- (1) diameter (inches) 4"
 - (2) total depth (feet) 170'
 - (3) static water level (feet) 105' below top of ground.
 - (4) casing PVC 160 (material) (depth)
4" (size) if telescope see back.
 - (5) screen 10 160 to 170 (length) (depth to top)
4" PVC (size) (material)
 - (6) pump 1/2 4 gpm (HP) (yield gpm)
K (type power)
 - (7) electric log (yes or no)
(organization running log)
 - (8) how well bottom plugged value

description of formations encountered	from	to
clay	0	20
sand & clay	20	40
sandy shale	40	70
shale	70	110
sandy shale & rock	110	120
sandy shale & shells fine sand	120	160
sand & shale	160	170
shale	170	225
sandy shale	225	300

DEPT. OF NATURAL RESOURCES
BUREAU OF LAND & WATER RESOURCES


NOV 9 - 1981

RECEIVED

DRILLERS REMARKS:

If well telescopes please
sketch and show depths.

GROUND LEVEL

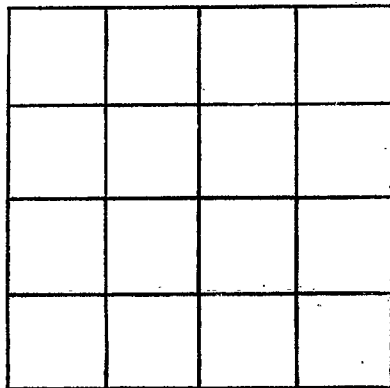

RECEIVED

81 NOV 9 A 8: 54

SECTION _____

Please indicate well location X.

ADDITIONAL INFORMATION

If more than one screen,
show locations of each on sketch.