

Wayne  
7-20-82

MISSISSIPPI  
 BOARD OF WATER COMMISSIONERS  
 416 North State Street  
 Jackson, Mississippi 39201

WATER WELL DRILLERS LOG

9-2 1982 CARRS Well Service WAYNE  
 date well completed firm name county well located

LANDOWNER: DAN Doby  
WAYNESBORO  
 (mailing address)  
 WELL LOCATION:  
 sec. 29 T. 9 N. R. 6 E. S. W  
2 3/4 miles NNE of WAYNE  
 (distance) (direction) (nearest town)

description of formations encountered	from to	
Top Soil	0	3
Red + yellow CLAY	3	12
White CLAY	12	15
Pink CLAY w/ Brown Rock	15	18
Med white SD	18	38
Pink + white CLAY	39	43
COARSE white SD	43	73

WELL PURPOSE: HOME  
 (home, irrigation, municipal, industrial)

WELL COMPLETION DATA:  
 (1) diameter (inches) 2"  
 (2) total depth (feet) 73  
 (3) static water level (feet) 53 below above top of ground.  
 (4) casing PVC, 68'  
 (material) (depth)  
 (size) If telescope see back.  
 (5) screen 5', 68'  
 (length) (depth to top)  
2", PVC (9 slotted)  
 (size) (material)  
 (6) pump 1, 5  
 (HP) (yield gpm)  
Elect  
 (type power)  
 (7) electric log (yes or no)  
 (organization running log)  
 (8) how well bottom plugged 2" CAP

DRILLERS REMARKS:


DEPT. OF NATURAL RESOURCES  
 BUREAU OF LAND & WATER RESOURCES

NOV - 1 1982

RECEIVED

If well telescopes please sketch and show depths.

GROUND LEVEL

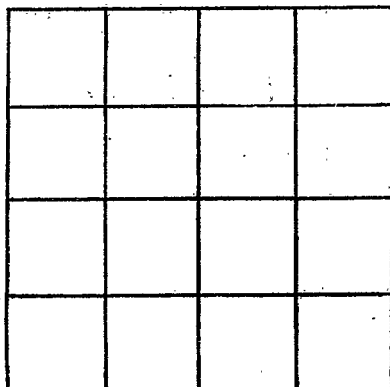

SECTION \_\_\_\_\_

Please indicate well location X.

ADDITIONAL INFORMATION

If more than one screen, show locations of each on sketch.