

MISSISSIPPI DEPARTMENT OF NATURAL RESOURCES

Bureau of Land and Water Resources

Southport Mall

P.O. Box 10631

Jackson, Mississippi 39209

WATER WELL DRILLERS LOG

Wayne  
J 2038

Feb 24 1983 Porter Drilling & Log Wayne  
 date well completed firm name county well located

LANDOWNER: David Helford  
Box 132 BB  
Waynesboro Miss.  
 (mailing address)

description of formations encountered	from	to
<u>clay &amp; sand</u>	<u>0</u>	<u>45</u>
<u>white coarse sand</u>	<u>45</u>	<u>81</u>
<u>more slightly coarse</u>	<u>81</u>	<u>94</u>
<u>stagnant white stiff</u>		
<u>red sand</u>		

WELL LOCATION:  
 sec. 20 T. 9 (N) S. R. 6 (E) W.  
3 1/2 miles N of Waynesboro  
 (distance) (direction) (nearest town)

62' 1" P.V.C. drop pipe

WELL PURPOSE: home  
 (home, irrigation, municipal, industrial)

- WELL COMPLETION DATA:
- (1) diameter (inches) 2"
  - (2) total depth (feet) 80'
  - (3) static water level (feet) 52 below above top of ground.
  - (4) casing P.V.C. 75'  
 (material) (depth)
  - 2"  
 (size) If telescope see back.
  - (5) screen 5' 75'  
 (length) (depth to top)
  - 2" balata S.S.  
 (size) (material)
  - (6) pump 1 12  
 (HP) (yield gpm)
  - elec.  
 (type power)
  - (7) electric log no  
 (yes or no)
  - (organization running log)
  - (8) how well bottom plugged 2" sand shark

DEPT. OF NATURAL RESOURCES  
 BUREAU OF LAND & WATER RESOURCES


MAY 2 - 1983

RECEIVED

DRILLERS REMARKS:

If well telescopes please sketch and show depths.

GROUND LEVEL

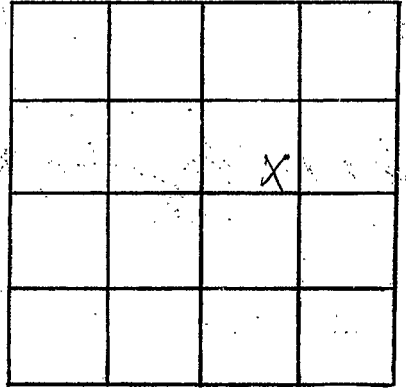

SECTION 20

Please indicate well location X.

ADDITIONAL INFORMATION

If more than one screen, show locations of each on sketch.