

Wayne
Jones

MISSISSIPPI
BOARD OF WATER COMMISSIONERS
416 North State Street
Jackson, Mississippi 39201
WATER WELL DRILLERS LOG

1984 CARRS well service WAYNE
firm name county well located

date well completed

LANDOWNER: Bruce Langley

BT, 2

WAYNESBORO, MS.
(mailing address)

WELL LOCATION:

sec 28 T 9 N R 6 E W

(distance) miles (direction) of (nearest town)

WELL PURPOSE:
(home, irrigation, municipal, industrial)

WELL COMPLETION DATA:

- (1) diameter (inches) 2"
- (2) total depth (feet) 93
- (3) static water level (feet) 47 below above top of ground.
- (4) casing pre 2" 83 (material) (depth)
- (5) screen 10" 83 (length) (depth to top)
- (6) electric log NO (yes or no)
- (7) electric log NO (yes or no)
- (8) how well bottom plugged 2" CAP

DRILLERS REMARKS:

description of formations encountered

from to

description of formations encountered	from	to
TOP	0	2
VEE SD.	2	8
W-VEL CLAY	8	16
FINE W. SD.	16	22
WHT. CLAY	22	38
MED. + FINE WHT. SD.	38	56
WHT. CLAY	56	63
MED. + FINE WHT. SD.	63	78
WHT. SD.	78	93


DEPT. OF NATURAL RESOURCES
BUREAU OF LAND & WATER RESOURCES

FEB - 2 1984

RECEIVED

If well telescopes please sketch and show depths.

GROUND LEVEL

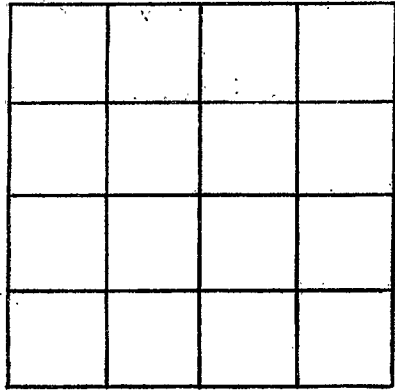

SECTION _____

Please indicate well location X.

ADDITIONAL INFORMATION

A series of horizontal lines for recording additional information, located below the 'ADDITIONAL INFORMATION' header.

A series of horizontal lines for recording additional information, located at the bottom right of the page.

If more than one screen, show locations of each on sketch.