

MISSISSIPPI DEPARTMENT OF NATURAL RESOURCES
Bureau of Land and Water Resources
 Southport Mall
 P.O. Box 10631
 Jackson, Mississippi 39209
WATER WELL DRILLERS LOG

Wayne
J
2041

5/20/84 19 CARR'S WELL SER. WAYNE
 date well completed firm name county well located

LANDOWNER: BOB DOBY
PT. 2 WAYNESBORO
MS. 39367
 (mailing address)

description of formations encountered	from	to
<u>R.D. SD</u>	<u>0</u>	<u>15</u>
<u>" SD CLY.</u>	<u>15</u>	<u>25</u>
<u>MED. WH SD.</u>	<u>25</u>	<u>35</u>
<u>C.R. WH SD.</u>	<u>35</u>	<u>57</u>
<u>WH CLAY</u>	<u>57</u>	<u>59</u>
<u>MED. WH. SD.</u>	<u>59</u>	<u>72</u>
<u>C.R. WH SD</u>	<u>-</u>	<u>-</u>
<u>WITH PR CLAY</u>	<u>72</u>	<u>78</u>

WELL LOCATION:
 sec 31 T 9C S R 6 E W
4 miles E of WAYNESBORO
 (distance) (direction) (nearest town)

WELL PURPOSE:
 (home) Irrigation, municipal, industrial

- WELL COMPLETION DATA:
- (1) diameter (inches) 2"
 - (2) total depth (feet) 78
 - (3) static water level (feet) _____ below/above top of ground.
 - (4) casing PVC 73
 (material) (depth)
2" if telescope see back.
 (size)
 - (5) screen 5' 73
 (length) (depth to top)
2" PVC
 (size) (material)
 - (6) pump 1 3
 (HP) (yield gpm)
ELEC
 (type power)
 - (7) electric log _____
 (yes or no)
 - _____ (organization running log)
 - (8) how well bottom plugged CAPPED

DRILLERS REMARKS: _____


DEPT. OF NATURAL RESOURCES
 BUREAU OF LAND & WATER RESOURCES

JUN 11 1984

RECEIVED

If well telescopes please sketch and show depths.

GROUND LEVEL

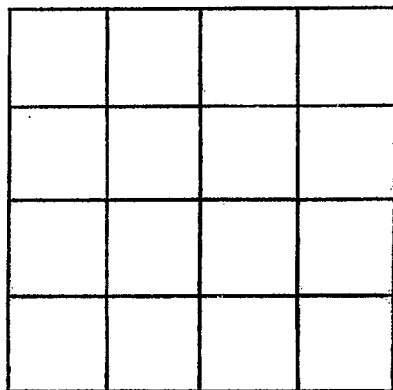

SECTION _____

Please indicate well location X.

ADDITIONAL INFORMATION

If more than one screen,
show locations of each on sketch.