

**MISSISSIPPI DEPARTMENT OF NATURAL RESOURCES**  
**Bureau of Land and Water Resources**  
 Southport Mall  
 P.O. Box 10631  
 Jackson, Mississippi 39209  
**WATER WELL DRILLERS LOG**

Wayne  
Jordan

June 5 19 84 Boyer Drilling & Sps Wayne  
 date well completed firm name county well located

LANDOWNER: Angus Jordan  
Box 6 Haynesboro, Miss  
 (mailing address)

WELL LOCATION:  
 sec. 8 T 9 N R 6 E  
6 miles N Haynesboro  
 (distance) (direction) (nearest town)

WELL PURPOSE: Home  
 (home, irrigation, municipal, industrial)

**WELL COMPLETION DATA:**

- (1) diameter (inches) 2"
- (2) total depth (feet) 63'
- (3) static water level (feet) 41' below above top of ground.
- (4) casing PVC 59'  
 (material) (depth)  
2' if telescope see back.  
 (size)
- (5) screen 4' 59'  
 (length) (depth to top)  
1/4" below S.S.  
 (size) (material)
- (6) pump 1 8  
 (HP) (yield gpm)  
elec.  
 (type power)
- (7) electric log no  
 (yes or no)
- (8) how well bottom plugged 1/4" sand stuck

DRILLERS REMARKS:

description of formations encountered	from	to
<u>red clay</u>	<u>0</u>	<u>20</u>
<u>red sand</u>	<u>20</u>	<u>50</u>
<u>clay &amp; sand</u>	<u>50</u>	<u>55</u>
<u>sand</u>	<u>55</u>	<u>63</u>
<u>stipar on clay</u>		
<u>57' 1" P.V.C. drop pipe</u>		


DEPT. OF NATURAL RESOURCES  
 BUREAU OF LAND & WATER RESOURCES

AUG 6 1984

**RECEIVED**

If well telescopes please  
sketch and show depths.

GROUND LEVEL

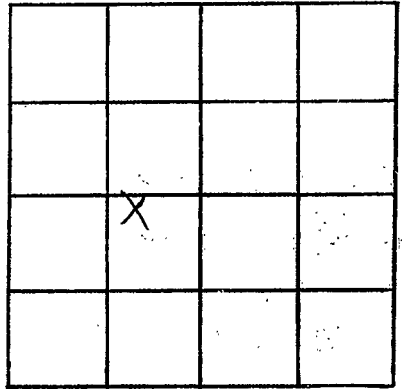

SECTION 8

Please indicate well location X.

ADDITIONAL INFORMATION

If more than one screen,  
show locations of each on sketch.