

Wayne
J
2043

MISSISSIPPI DEPARTMENT OF NATURAL RESOURCES
Bureau of Land and Water Resources
Southport Mall
P.O. Box 10631
Jackson, Mississippi 39209
WATER WELL DRILLERS LOG

Jan 20 19 24 Porter Drilling & Log Co. Itasca
date well completed firm name county well located

LANDOWNER: Mrs James Lighter
801 Clark Dr
Thayerboro Ms.
(mailing address)

description of formations encountered	from	to
red clay	0	15
sand + clay	15	25
clay & sand	25	36
blue clay	36	44
sand covered clay	44	54
stayed on clay &		
40' 1" P.V.C. dye pipe		

WELL LOCATION:
sec 34 T 9 N R 6 E
S W
4 miles NE of Thayerboro
(distance) (direction) (nearest town)

WELL PURPOSE: Camp
(home, irrigation, municipal, industrial)

- WELL COMPLETION DATA:
- (1) diameter (inches) 2
 - (2) total depth (feet) 54
 - (3) static water level (feet) 26 below above top of ground.
 - (4) casing PVC 49' (material) (depth)
2" (size) If telescope see back.
 - (5) screen 5' 49' (length) (depth to top)
2" (size) b.s. 5.5. (material)
 - (6) pump 3/4 8 (HP) (yield gpm)
elec. (type power)
 - (7) electric log sw (yes or no)
 - (organization running log)

(8) how well bottom plugged
2 sand sh.

DRILLERS REMARKS:


DEPT. OF NATURAL RESOURCES
BUREAU OF LAND & WATER RESOURCES

AUG 6 1984

RECEIVED

If well telescopes please sketch and show depths.

GROUND LEVEL

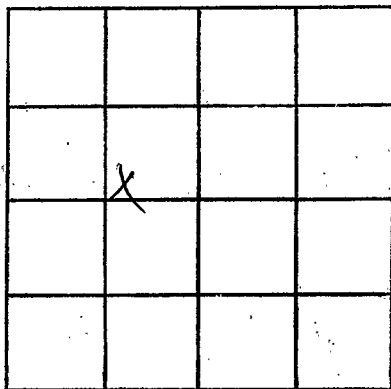

SECTION 34

Please indicate well location X.

ADDITIONAL INFORMATION

If more than one screen, show locations of each on sketch.