

MISSISSIPPI DEPARTMENT OF NATURAL RESOURCES
Bureau of Land and Water Resources
 Southport Mall
 P.O. Box 10631
 Jackson, Mississippi 39209
WATER WELL DRILLERS LOG

Wayne
J
2044

7/30 1984 CARR'S WELL SER. WAYNE
 date well completed firm name county well located

LANDOWNER: BOY FORTWORTH
Rt. 2 WAYNESBORO
MS. 39367
 (mailing address)

WELL LOCATION:
 sec. 27 9 N R 6 E
S (W)
7 miles SE of WAYNESBORO
 (distance) (direction) (nearest town)

WELL PURPOSE:
 (home) irrigation, municipal, industrial)

WELL COMPLETION DATA:

(1) diameter (inches) 2"

(2) total depth (feet) 173

(3) static water level (feet) 110 below above
 top of ground.

(4) casing 2" 160'
 (material) (depth)
2" if telescope see back.
 (size)

(5) screen OPEN HOLE
 (length) (depth to top)
 (size) (material)

(6) pump 2 8
 (HP) (yield gpm)
ELEC
 (type power)

(7) electric log NO
 (yes or no)
 (organization running log)

(8) how well bottom plugged CAPPED

description of formations encountered	from	to
TOP SOIL	0	1
FIN. R.D. SP.	1	15
MED. " "	15	20
FIN. WH. SD. & CLAY	20	30
FIN. WH. SD. ROCK	30	31
FIN. WH. SD. + CLAY	31	35
VEL. SD. & CLAY	36	49
BLU. CLAY	49	66
SD. ROCK	66	67
BLU. CLAY	67	70
BR. ROCK	70	71
BLU. CLAY	71	86
LIME HD. ROCK	86	87
DK. GR. CLAY	87	97
MED. LIME RK.	97	100
SOFT LIME "	100	102
MED. " "	102	103
GR. CLAY	103	133
MED. SF. L. ROCK	133	136
HD. L. ROCK	136	142
SOFT " "	140	145
HD. " "	145	145.5
SOFT " "	145.5	146
HD. " "	146	147
DROPPED	147	148
HD. LIME "	148	149
MEDITO SF " "	149	151
HD. LI " "	151	154
MED. SF. " "	154	156
HD. " "	156	157
SOFT " "	157	162
MED. " "	162	163
SOFT " "	163	172
MED. " "	172	173

DEPT. OF NATURAL RESOURCES
 BUREAU OF LAND & WATER RESOURCES


DRILLERS REMARKS:

SEP - 4 1984

RECEIVED

If well telescopes please
sketch and show depths.

GROUND LEVEL

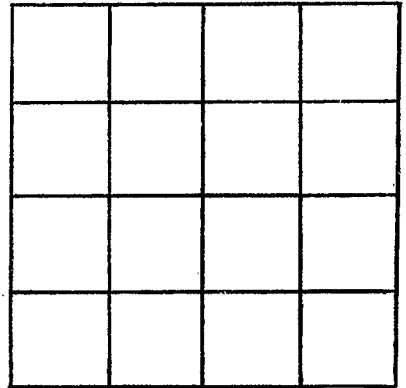

SECTION _____

Please indicate well location X.

ADDITIONAL INFORMATION

If more than one screen,
show locations of each on sketch.