

MISSISSIPPI DEPARTMENT OF NATURAL RESOURCES
Bureau of Land and Water Resources
 Southport Mall
 P.O. Box 10631
 Jackson, Mississippi 39209
WATER WELL DRILLERS LOG

Wayne
of 2045

date well completed 9-13 1984 Roy L. West Drilling firm name Wayne county well located

LANDOWNER:
Tom O'Connell
Wayneboro MS
 (mailing address)

description of formations encountered	from	to
	SAND	0
CLAY	2	18
SAND	18	32
CLAY	32	68
SAND	68	86

WELL LOCATION:
 sec. 27 T 7 N R. 6 E
2 miles NE of Wayneboro
 (distance) (direction) (nearest town)


WELL PURPOSE:
 (home, irrigation, municipal, industrial)

- WELL COMPLETION DATA:**
- diameter (inches) 2"
 - total depth (feet) 86'
 - static water level (feet) 38' below above top of ground.
 - casing PVC 81'
 (material) (depth)
 (size) if telescope see back.
 - screen 5' 81'
 (length) (depth to top)
2" PVC
 (size) (material)
 - pump 1 12
 (HP) (yield gpm)
REA
 (type power)
 - electric log No
 (yes or no)
 (organization running log)
 - how well bottom plugged WASH VALVE

DRILLERS REMARKS:

If well telescopes please sketch and show depths.

GROUND LEVEL

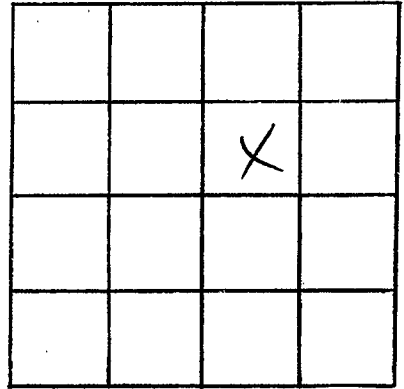

SECTION 27

Please indicate well location X.

ADDITIONAL INFORMATION

If more than one screen,
show locations of each on sketch.