

MISSISSIPPI DEPARTMENT OF ENVIRONMENTAL QUALITY  
Bureau of Land and Water Resources

P. O. Box 10631  
Jackson, MS 39289-0631  
WATER WELL DRILLERS LOG

COUNTY WELL LOCATED  
**Wayne**

WELL NUMBER  
**J**

CODED

DATE WELL COMPLETED  
**11/30/90**

PERMIT NUMBER  
**0-402**

NAME OF DRILLING FIRM  
**Turn On Drilling**

**Water Well**

NAME & MAILING ADDRESS OF LANDOWNER  
**Exeter Drilling Co.**  
**Southern Division**  
**P.O. Box 1478**  
**Houston, TX 77251-1478**

WELL LOCATION: SEC **3** TOWNSHIP **9 N** RANGE **16 E**

DISTANCE **1** Miles DIRECTION **N** of NEAREST TOWN **Waynesboro**

OTHER LANDMARK

WELL PURPOSE: Home, Irrigation, Municipal, Industrial, Fish Pond, etc.  
**Rig Supply**

PUMP DATA

PUMP TYPE (Circle One):  
Submersible, Turbine, Jet, Flowing Well,  
Other (Describe)

POWER TYPE (Circle One):  
Electric, Tractor, Diesel, Gasoline, Butane,  
Other (Describe) H/P

Pump Capacity (GPM) No. of Stages Setting Depth FT.

PUMP TEST  
Well yielded \_\_\_\_\_ GPM with  
a drawdown of \_\_\_\_\_ ft.  
after \_\_\_\_\_ hours of pumping

WELL DATA

Well Depth	Casing Diameter (In.)	Casing Length (Ft.)
Type of Casing	Hole Depth	Depth to Static Water Level

TYPE OF COMPLETION: (Circle One or More):  
Gravel Packed, Underreamed, Telescoped,  
Natural Development, Open Hole, Other (Describe)

Top of Lap Pipe or Reduction in Casing

FEET IF TELESCOPED OR MORE THAN ONE SCREEN: USE BACK PAGE

LOG DATA

TYPE OF LOG RUN (Circle One):  
Electric, Gamma Ray, Density, Sonic, Neutron, Other (Describe) **No Log Run**

Name of Organization Running Log

SCREEN DATA

Diameter - Inches <b>4"</b>	Length - Feet	Slot Size - Inches
Screen Type <b>PVC Slot</b>	Depth to Bottom - Feet	

GEOLOGIC DATA (Office Use Only)

Surface Elev.	Geologic Unit	Unit Thickness	Depth to Top
Subs. SWL	Date	Analysis	Aquifer Test

Driller's Remarks  
**Dry Hole**  
**No usable Sand Found**  
**Drilling Stopped by Owner**

DESCRIPTION OF FORMATIONS ENCOUNTERED	FROM	TO	FORMATIONS (Continued)	FROM	TO
Field Dirt	1	15	Fine Sand	460	465
Clay	15	45	<b>DECEIVED</b>	465	602
Sand	45	81			
Rock	81	82			
Clay	82	110			
Rock	110	112			
Clay	112	150			
Rock	150	152			
Clay	152	210			
Limestone (clay)	210	340			
Clay	340	460			


FEB 26 1991

Dept. of Environmental Quality  
Bureau of Land & Water Resources

IF MORE SPACE IS NEEDED, USE BACK

If well telescopes please  
sketch and show depths.

GROUND LEVEL

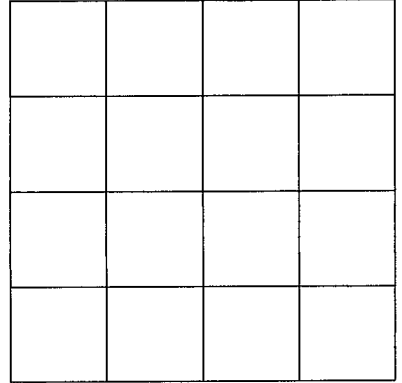

SECTION \_\_\_\_\_

Please indicate well location X.

ADDITIONAL INFORMATION

If more than one screen,  
show location of each on sketch.