

MISSISSIPPI DEPARTMENT OF ENVIRONMENTAL QUALITY
Bureau of Land and Water Resources

P. O. Box 10631
Jackson, MS 39289-0631
WATER WELL DRILLERS LOG

COUNTY WELL LOCATED Wayne	
WELL NUMBER 2	CODED
DATE WELL COMPLETED 2053 11-18-91	

PERMIT NUMBER
NAME OF DRILLING FIRM Roy West

NAME & MAILING ADDRESS OF LANDOWNER Curtis Hudson			
Rt 2 Box 106			
Waynesboro MS			
WELL LOCATION:	SEC	TOWNSHIP	RANGE
	8	9 N S	6 E W
DISTANCE	DIRECTION	NEAREST TOWN	
12 Miles	NE	of Waynesboro	
OTHER LANDMARK			
WELL PURPOSE <input checked="" type="radio"/> Home, <input type="radio"/> Irrigation, Municipal, Industrial, Fish Pond, etc.			

PUMP DATA		
PUMP TYPE (Circle One): Submersible, Turbine, <input checked="" type="radio"/> Jet, Flowing Well, Other (Describe) _____		
POWER TYPE (Circle One): <input checked="" type="radio"/> Electric, Tractor, Diesel, Gasoline, Butane, Other (Describe) _____ H/P _____		
Pump Capacity (GPM) 10	No. of Stages	Setting Depth _____ FT.
PUMP TEST		
Well yielded _____ GPM with a drawdown of _____ ft. after _____ hours of pumping		

WELL DATA		
Well Depth 240	Casing Diameter (In.) 2	Casing Length (Ft.) 230'
Type of Casing PVC	Hole Depth 240	Depth to Static Water Level 90'
TYPE OF COMPLETION: (Circle One or More): <input checked="" type="radio"/> Gravel Packed, <input type="radio"/> Underreamed, <input type="radio"/> Telescoped, <input checked="" type="radio"/> Natural Development, <input type="radio"/> Open Hole, <input type="radio"/> Other		
Top of Lap Pipe or Reduction in Casing _____		
FEET <input type="checkbox"/> IF TELESCOPED OR MORE THAN ONE SCREEN: USE BACK PAGE		

LOG DATA	
TYPE OF LOG RUN (Circle One): Electric, Gamma Ray, Density, Sonic, Neutron, Other (Describe) _____	
Name of Organization Running Log _____	

SCREEN DATA		
Diameter - Inches 2	Length - Feet 10	Slot Size - Inches .008
Screen Type PVC	Depth to Bottom - Feet 240	


GEOLOGIC DATA (Office Use Only)			
Surface Elev.	Geologic Unit	Unit Thickness	Depth to Top
Subs. SWL	Date	Analysis	Aquifer Test
Driller's Remarks			

DESCRIPTION OF FORMATIONS ENCOUNTERED	FROM	TO
SANDY CLAY	0	16
Limestone	16	54
CLAY	54	223
SAND & Rock streaks	223	240

FORMATIONS (Continued)		FROM	TO
RECEIVED			
JAN 10 1992			
Dept. of Environmental Quality			
Bureau of Land & Water Resources			
IF MORE SPACE IS NEEDED, USE BACK			

If well telescopes please
sketch and show depths.

GROUND LEVEL

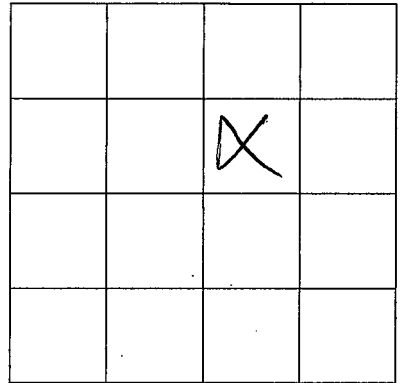

SECTION

J

Please indicate well location X.

ADDITIONAL INFORMATION

If more than one screen,
show location of each on sketch.