

K3

7-25-63

WATER WELL DRILLERS LOG

Date: July 25, 1963, Driller: Porter Drilling & Log Co., Wayne

(1) Owner of Land: Edward Mayfield
 (Name)
Rt 2 Waynesboro
 (Address)

(2) Location: SE 1/4, SE 1/4, Sec. 29 T9 R5
9 miles NE of Waynesboro
 (distance) (direction) (Nearest Town)

(3) Topography: hilly
 (Hilly) (Flat) (Level)

(4) Purpose of Well: domestic
 (Domestic Irrigation
 Municipal, Industrial, Other)

Description & Color of Materials Sand, Clay, Red Clay, Shell, etc.	Thick- ness Feet	Depth Feet
red clay & sand	25	25
chalk & sand	35	60
sand	10	70
chalk	15	85
fine sand	5	90
blue chalk	12	102
strata of soft rock	18	120
blue chalk	40	160
white shale	5	165
redwood hole on rock at 165'		
honeycomb rock	21	186
mostly white chalk	16	202

Information upon completion of well:

(1) Diameter 2" inches.

(2) Total Depth 202 feet.

(3) Water Level 138 feet below top of ground.


(4) Cased to 165', Size 2"

(5) Screen: Size none, Length _____

(6) Were any formations sealed against pollution?
~~yes~~, X no.

If YES depth of formation _____
 Why _____

Drillers Remarks: _____

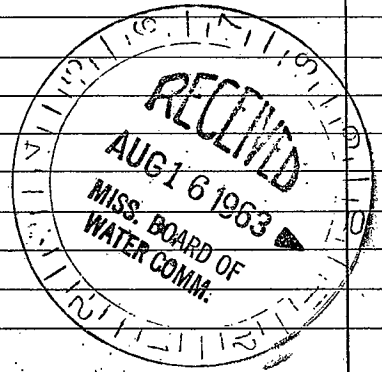

(Use Back Side)

Well No.

