

K4
9-19-63

WATER WELL DRILLERS LOG

Date: Sept. 19, 1963, Driller: Porter Drilling Co. County Wayne
(Name)

(1) Owner of Land: Jim Walker
(Name)
Rt 2 Waverboro
(Address)
(2) Location: SW 1/4, SE 1/4, Sec. 33 T9 R5,
9 miles NE, of Waverboro
(distance) (direction) (Nearest Town)
(3) Topography: hilly
(Hilly) (Flat) (Level)
(4) Purpose of Well: domestic
(Domestic Irrigation
Municipal, Industrial, Other)


Description & Color of Materials Sand, Clay, Red Clay, Shell, etc.	Thick- ness Feet	Depth Feet
<u>red clay</u>	<u>6</u>	<u>6</u>
<u>red sand & fine gravel</u>	<u>16</u>	<u>22</u>
<u>chack</u>	<u>8</u>	<u>30</u>
<u>red sand</u>	<u>18</u>	<u>48</u>
<u>course sand</u>	<u>16</u>	<u>64</u>
<u>fine red sand</u>	<u>12</u>	<u>76</u>
<u>sand & fine gravel</u>	<u>6</u>	<u>82</u>
<u>fine red sand</u>	<u>3</u>	<u>85</u>

Information upon completion of well:

(1) Diameter 2' inches.
(2) Total Depth 82' feet.
(3) Water Level 64' feet below top of ground.
(4) Cased to 76', Size 2"
(5) Screen: Size 1 1/4", Length 6'
(6) Were any formations sealed against pollution?
_____ yes, X no.

If YES depth of formation _____
Why _____

Drillers Remarks: _____

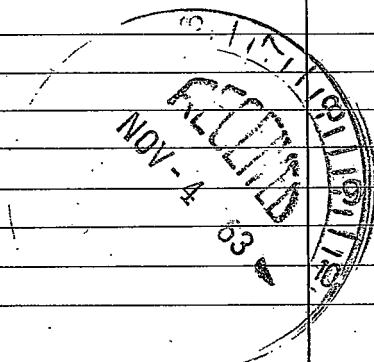

(Use Back Side)

Well No.

